


1 LOCATION OF WATER WELL: Fraction NW 1/4 NW 1/4 NE 1/4 Section Number 19 Township Number T 9 S Range Number R 28 W EW  
 County: Sheridan  
 Distance and direction from nearest town or city street address of well if located within city?  
 N/A - LOCATION CONFIRMED BY GMD #4

2 WATER WELL OWNER: Clark Chipman  
 RR#, St. Address, Box # : c/o Michael Haas Board of Agriculture, Division of Water Resources  
 City, State, ZIP Code : Hoxie, KS 67740 Application Number:

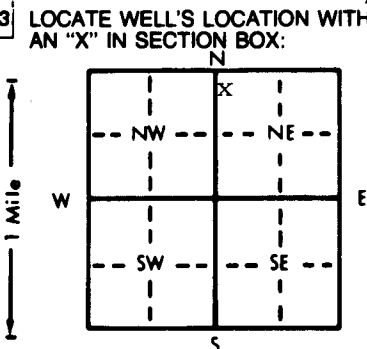

4 DEPTH OF COMPLETED WELL..... ft. ELEVATION: ..... ft.  
 Depth(s) Groundwater Encountered 1..... ft. 2..... ft. 3..... ft.  
 WELL'S STATIC WATER LEVEL ..... ft. below land surface measured on mo/day/yr .....  
 Pump test data: Well water was ..... ft. after ..... hours pumping ..... gpm  
 Est. Yield ..... gpm: Well water was ..... ft. after ..... hours pumping ..... gpm  
 Bore Hole Diameter.....in. to .....ft., and.....in. to .....ft.  
 WELL WATER TO BE USED AS: 5 Public water supply 8 Air conditioning 11 Injection well  
 X1 Domestic 3 Feedlot 6 Oil field water supply 9 Dewatering 12 Other (Specify below)  
 2 Irrigation 4 Industrial 7 Lawn and garden only 10 Monitoring well .....  
 Was a chemical/bacteriological sample submitted to Department? Yes.....No.....; If yes, mo/day/yr sample was submitted  
 Water Well Disinfected? Yes No

5 TYPE OF BLANK CASING USED: 5 Wrought iron 8 Concrete tile CASING JOINTS: Glued ..... Clamped .....  
 X1 Steel 3 RMP (SR) 6 Asbestos-Cement 9 Other (specify below) Welded .....  
 2 PVC 4 ABS 7 Fiberglass ..... Threaded.....  
 Blank casing diameter .....in. to .....ft., Dia.....in. to .....ft., Dia.....in. to .....ft.  
 Casing height above land surface... 0.....in., weight..... lbs./ft. Wall thickness or gauge No. ....  
 TYPE OF SCREEN OR PERFORATION MATERIAL: 7 PVC 10 Asbestos-cement  
 1 Steel 3 Stainless steel 5 Fiberglass 8 RMP (SR) 11 Other (specify) .....  
 2 Brass 4 Galvanized steel 6 Concrete tile 9 ABS 12 None used (open hole)  
 SCREEN OR PERFORATION OPENINGS ARE: 5 Gauzed wrapped 8 Saw cut 11 None (open hole)  
 1 Continuous slot 3 Mill slot 6 Wire wrapped 9 Drilled holes  
 2 Louvered shutter 4 Key punched 7 Torch cut 10 Other (specify) .....  
 SCREEN-PERFORATED INTERVALS: From..... ft. to .....ft., From..... ft. to .....ft.  
 From..... ft. to .....ft., From..... ft. to .....ft.  
 GRAVEL PACK INTERVALS: From..... ft. to .....ft., From..... ft. to .....ft.  
 From..... ft. to .....ft., From..... ft. to .....ft.

6 GROUT MATERIAL: 1 Neat cement 2 Cement grout 3 Bentonite 4 Other ..... NOV 30 1989  
 Grout Intervals: From..... ft. to .....ft., From..... ft. to .....ft., From..... ft. to .....ft.  
 What is the nearest source of possible contamination:  
 1 Septic tank 4 Lateral lines 7 Pit privy 10 Livestock pens 14 Abandoned water well  
 2 Sewer lines 5 Cess pool 8 Sewage lagoon 11 Fuel storage 15 Oil well/Gas well  
 3 Watertight sewer lines 6 Seepage pit 9 Feedyard 12 Fertilizer storage 16 Other (specify below)  
 13 Insecticide storage  
 Direction from well? How many feet?

FROM	TO	LITHOLOGIC LOG	FROM	TO	PLUGGING INTERVALS
					Old well is located in a well pit approximately 4-5 ft. deep.
			Bottom	4	Clay w/some sand mixed
			4	1	Concrete
			1	Top of casing	Topsoil
		INFORMATION			
		AT			The concrete top & walls of the old well pit were removed and the pit filled w/ topsoil.
		RIGHT			

7 CONTRACTOR'S OR LANDOWNER'S CERTIFICATION: This water well was (1) constructed, (2) reconstructed, or (3) plugged under my jurisdiction and was completed on (mo/day/year) 11-11-89 and this record is true to the best of my knowledge and belief. Kansas Water Well Contractor's License No. .... This Water Well Record was completed on (mo/day/yr) ..... by (signature) Keith Caldwell  
 under the business name of Tennant

RECEIVED

DIVISION OF ENVIRONMENT

OFFICE USE ONLY  
T  
R  
EW  
SEC.  
1/4  
1/4  
1/4