USE TYPEWRITER OR BALL POINT PEN-PRESS FIRMLY, PRINT CLEARLY.

DCD

WATER WELL RECORD
KSA 82a-1201-1215

Kansas Department of Health and Environment-Division of Environment
(Water well Contractors)
Topeka, Kansas 66620

1. Location of well:	County	Fraction	Section number	Township number	Range number
	Sheridan	SE 1/4 SW 1/4 SE 1/4	23	T 9 S	R 28 E/W

2. Distance and direction from nearest town or city: From Hoxie; 7 South; 13/4 East
Street address of well location if in city:

3. Owner of well: Wendolin Ochs
R.R. or street:
City, state, zip code: Hoxie, Kansas

4. Locate with "X" in section below: Sketch map:

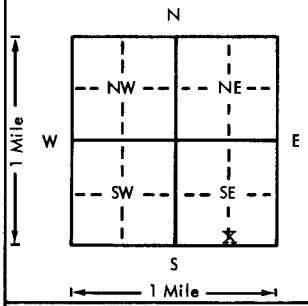

6. Bore hole dia. 30 in. Completion date 8-9-76
Well depth 210 ft.

7. __ Cable tool __ Rotary __ Driven __ Dug
__ Hollow rod __ Jetted __ Bored X Reverse rotary

8. Use: __ Domestic __ Public supply __ Industry
X Irrigation __ Air conditioning __ Stock
__ Lawn __ Oil field water __ Other

9. Casing: Material Steel Height: Above or ~~Below~~
Threaded ___ Welded X Surface 12 in.
RMP ___ PVC ___ Weight .188 lbs./ft.
Dia. 16 in. to 140 ft. depth Wall Thickness: inches or
Dia. ___ in. to ___ ft. depth gage No. #7

5. Type and color of material	From	To
Clay	0	20
Clay Streaks of Gravel	20	60
Gravel Streak of Clay	60	80
Clay Streaks of Gravel	80	140
Clay	140	152
Gravel	152	160
Gravel Streaks of Clay	160	180
Gravel	180	185
Clay, Streaks of Gravel	185	200
Gravel, STreaks of Clay	200	209
Ochre & Shale	209	210
BROCK 209'		
(Use a second sheet if needed)		

10. Screen: Manufacturer's name W. A. Brown
Type Bridge Dia. 16"
Slot/gauze 10% Length 60'
Set between 140 ft. and 200 ft.
10' John. 200 ft. and 210 ft.
Gravel pack? X Size range of material ½x5/8

11. Static water level: mo./day/yr.
132 ft. below land surface Date 8-11-76

12. Pumping level below land surfaces:
___ ft. after ___ hrs. pumping ___ g.p.m.
206 ft. after 2 hrs. pumping 1200 g.p.m.
Estimated maximum yield 1200 g.p.m.

13. Water sample submitted: mo./day/yr.
___ Yes X No Date

14. Well head completion:
___ Pitless adapter 12 Inches above grade

15. Well grouted? X
With: ___ Neat cement X Bentonite X Clay ~~Concrete~~
Depth: From 0 ft. to 10 ft.

16. Nearest source of possible contamination:
ft. 9400 Direction W Type House
Well disinfected upon completion? ___ Yes X No

17. Pump: ___ Not installed
Manufacturer's name Floway
Model number 056139 HP 75 Volts 480
Length of drop pipe 200 ft. capacity ___ g.p.m.
Type: 4 stage 12: DOM Bowl
___ Submersible X Turbine
___ Jet ___ Reciprocating
___ Centrifugal ___ Other

18. Elevation:

Topography:
___ Hill
X Slope
___ Upland
___ Valley

19. Remarks:

20. Water well contractor's certification:
This well was drilled under my jurisdiction and this report is true to the best of my knowledge and belief.
Western Well & Pump 245
Business name License No.
Address Box 852, Colby, KS 67701
Signed Sally Berry Date 9-22-76
Authorized representative

T 9 R 28 E/W Sec 23 1/4 SE 1/4 SE 1/4

Forward the white, blue and pink copies to the Department of Health and Environment

Form WWC-5

MI-1023