USE TYPEWRITER OR BALL POINT PEN-PRESS FIRMLY, PRINT CLEARLY.

WATER WELL RECORD
KSA 82a-1201-1215

Kansas Department of Health and Environment-Division of Environment
(Water well Contractors)
Topeka, Kansas 66620

1. Location of well:	County	Fraction	Section number	Township number	Range number
	Sheridan	NE 1/4 NE 1/4 NE 1/4	26	T 9 S	R 28 E/W

2. Distance and direction from nearest town or city: 7 South 2 East of Hoxie
Street address of well location if in city:

3. Owner of well: Herman Niermeir
R.R. or street: Rt. 2
City, state, zip code: Hoxie, Ks. 67740

4. Locate with "X" in section below:

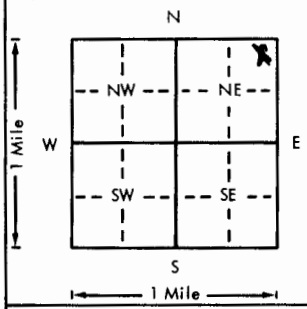

Sketch map:

6. Bore hole dia. 9 in. Completion date 9-17-80
Well depth 205 ft.

7. __ Cable tool X Rotary __ Driven __ Dug
__ Hollow rod __ Jetted __ Bored __ Reverse rotary

8. Use: X Domestic __ Public supply __ Industry
__ Irrigation __ Air conditioning __ Stock
__ Lawn __ Oil field water __ Other

9. Casing: Material Styrene Height: Above or below
Threaded ___ Welded ___ Surface 12 in.
RMP ___ PVC ___ Weight 1.75 lbs./ft.
Dia. 5 in. to 205 ft. depth Wall Thickness: inches or
Dia. ___ in. to ___ ft. depth gage No. .214

5. Type and color of material

	From	To
Sand & Clay Layers	0	135
Medium Sand	135	138
Clay	138	154
Medium Sand	154	161
Cemented Layers	161	162
Medium Sand	162	164
Caliche	164	166
Medium Sand	166	169
Sandy Clay	169	173
Medium Sand	173	184
Fine Sand	184	186
Medium Sand	186	187
CSlay	187	190
Medium Sand	190	194
Clay	194	196
Medium to Coarse Sand & Gravel	196	205
Ochre	205	210

(Use a second sheet if needed)

10. Screen: Manufacturer's name
Type Styrene Dia. 5 in.
Slot/gauze Slot Length
Set between 185 ft. and 205 ft.
___ ft. and ___ ft.
Gravel pack? X Size range of material 1/4 in.

11. Static water level:
135 ft. below land surface Date 9-17-80 mo./day/yr.

12. Pumping level below land surfaces:
___ ft. after ___ hrs. pumping ___ g.p.m.
___ ft. after ___ hrs. pumping ___ g.p.m.
Estimated maximum yield ___ g.p.m.

13. Water sample submitted: mo./day/yr.
__ Yes X No Date

14. Well head completion:
X Pitless adapter ___ Inches above grade

15. Well grouted? yes
With: X Neat cement __ Bentonite __ Concrete
Depth: From 5 ft. to 15 ft.

16. Nearest source of possible contamination: Septic TAnk
ft. 220 Direction South Type
Well disinfected upon completion? ___ Yes ___ No

17. Pump: X Not installed
Manufacturer's name
Model number HP Volts
Length of drop pipe ft. capacity g.p.m.
Type:
__ Submersible __ Turbine
__ Jet __ Reciprocating
__ Centrifugal __ Other

18. Elevation:

Topography:
__ Hill
__ Slope
__ Upland
__ Valley

19. Remarks:

20. Water well contractor's certification:
This well was drilled under my jurisdiction and this report is true to the best of my knowledge and belief.
Business name F & W Drilling License No. 394A
Address Rt. 1 Hoxie, Ks. 67740
Signed Walt Wolf Date
Authorized representative

T 9 S R 28 E/W Sec 26 1/4 1/4 1/4 NE NE NE

Forward the white, blue and pink copies to the Department of Health and Environment

Form WWC-5

MI-1023