


1 LOCATION OF WATER WELL: Fraction SW SW SW Section Number 28 Township Number T 9 S Range Number R 28 County: Sheridan EW

Distance and direction from nearest town or city street address of well if located within city?

9 N of Grainfield

2 WATER WELL OWNER: Ed Goetz Board of Agriculture, Division of Water Resources
 RR#, St. Address, Box #: Grainfield, Ks 67737 Application Number:
 City, State, ZIP Code: _____

3 LOCATE WELL'S LOCATION WITH AN "X" IN SECTION BOX:

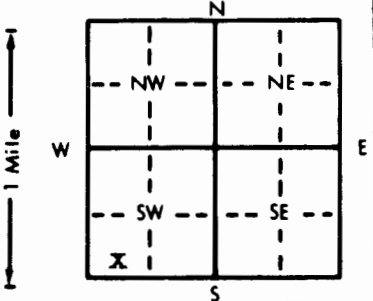

4 DEPTH OF COMPLETED WELL... 180 ft. ELEVATION: _____
 Depth(s) Groundwater Encountered 1. _____ ft. 2. _____ ft. 3. _____ ft.
 WELL'S STATIC WATER LEVEL... 102 ft. below land surface measured on mo/day/yr 6-29-88
 Pump test data: Well water was not tested after _____ hours pumping _____ gpm
 Est. Yield _____ gpm; Well water was _____ ft. after _____ hours pumping _____ gpm
 Bore Hole Diameter... 8 in. to 180 ft., and _____ in. to _____ ft.
 WELL WATER TO BE USED AS:
 1 Domestic 3 Feedlot 6 Oil field water supply 9 Dewatering 11 Injection well
 2 Irrigation 4 Industrial 7 Lawn and garden only 10 Observation well
 Was a chemical/bacteriological sample submitted to Department? Yes _____ No X; If yes, mo/day/yr sample was submitted _____
 Water Well Disinfected? Yes X No _____

5 TYPE OF BLANK CASING USED:
 1 Steel 3 RMP (SR) 5 Wrought iron 8 Concrete tile CASING JOINTS: Glued X Clamped _____
 2 PVC 4 ABS 6 Asbestos-Cement 9 Other (specify below) Welded _____
 7 Fiberglass Threaded _____
 Blank casing diameter... 5 in. to 180 ft., Dia _____ in. to _____ ft., Dia _____ in. to _____ ft.
 Casing height above land surface... 18 in., weight 1 8/10 lbs./ft. Wall thickness or gauge No. 1/4"
 TYPE OF SCREEN OR PERFORATION MATERIAL:
 1 Steel 3 Stainless steel 5 Fiberglass 8 RMP (SR) 10 Asbestos-cement 11 Other (specify) _____
 2 Brass 4 Galvanized steel 6 Concrete tile 9 ABS 12 None used (open hole)
 SCREEN OR PERFORATION OPENINGS ARE:
 1 Continuous slot 3 Mill slot 5 Gauzed wrapped 8 Saw cut 11 None (open hole)
 2 Louvered shutter 4 Key punched 6 Wire wrapped 9 Drilled holes
 7 Torch cut 10 Other (specify) _____
 SCREEN-PERFORATED INTERVALS: From... 160 ft. to 180 ft., From _____ ft. to _____ ft.
 From _____ ft. to _____ ft., From _____ ft. to _____ ft.
 GRAVEL PACK INTERVALS: From... 18 ft. to 180 ft., From _____ ft. to _____ ft.
 From _____ ft. to _____ ft., From _____ ft. to _____ ft.

6 GROUT MATERIAL: 1 Neat cement 2 Cement grout 3 Bentonite 4 Other _____
 Grout intervals: From... 4 ft. to 18 ft., From _____ ft. to _____ ft., From _____ ft. to _____ ft.
 What is the nearest source of possible contamination:
 1 Septic tank 4 Lateral lines 7 Pit privy 10 Livestock pens 14 Abandoned water well
 2 Sewer lines 5 Cess pool 8 Sewage lagoon 11 Fuel storage 15 Oil well/Gas well
 3 Watertight sewer lines 6 Seepage pit 9 Feedyard 12 Fertilizer storage 16 Other (specify below)
 13 Insecticide storage
 Direction from well? east How many feet? 300

FROM	TO	LITHOLOGIC LOG	FROM	TO	LITHOLOGIC LOG
0	19	top soil			
19	51	sandy clay			
51	65	ssnd and sand rock strips			
65	83	sand rock hard			
83	142	sand and sand clay strips			
142	166	sand and sand rock strips			
166	178	sand			
178	180	oker and shale			

7 CONTRACTOR'S OR LANDOWNER'S CERTIFICATION: This water well was (1) constructed, (2) reconstructed, or (3) plugged under my jurisdiction and was completed on (mo/day/year) 6-29-88 and this record is true to the best of my knowledge and belief. Kansas Water Well Contractor's License No. 139 This Water Well Record was completed on (mo/day/yr) 7-10-88 under the business name of Bartell Drilling by (signature) Jayce Bartell
 INSTRUCTIONS: Use typewriter or ball point pen. PLEASE PRESS FIRMLY and PRINT clearly. Please fill in blanks, underline or circle the correct answers. Send top three copies to Kansas Department of Health and Environment, Bureau of Water Protection, Topeka, Kansas 66620-7320, Telephone: 913-862-9360. Send one to WATER WELL OWNER and retain one for your records.

OFFICE USE ONLY T R EW SEC. 1/4 1/4 1/4