


1 LOCATION OF WATER WELL: Fraction C 1/4 N 1/2 1/4 SW 1/4 Section Number 29 Township Number T 9 S Range Number R 28 **EW**

Distance and direction from nearest town or city street address of well if located within city?
 8 Miles South, 2 Miles West, 1/4 Mile North

2 WATER WELL OWNER: Edward Goetz File #26759
 RR# , St. Address, Box # : RR 2 Box 23 Board of Agriculture, Division of Water Resources
 City, State, ZIP Code : Grainfield, Ks. 67737 Application Number:

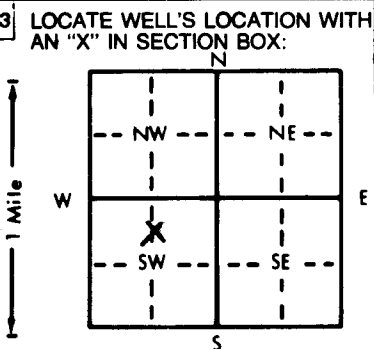

4 DEPTH OF COMPLETED WELL: 178 ft. ELEVATION:

Depth(s) Groundwater Encountered 1. ft. 2. ft. 3. ft.

WELL'S STATIC WATER LEVEL: 95 ft. below land surface measured on mo/day/yr

Pump test data: Well water was ft. after hours pumping gpm

Est. Yield gpm: Well water was ft. after hours pumping gpm

Bore Hole Diameter: 30 in. to 178 ft., and in. to ft.

WELL WATER TO BE USED AS:

5 Public water supply	8 Air conditioning	11 Injection well
1 Domestic	3 Feedlot	6 Oil field water supply
2 Irrigation	4 Industrial	7 Lawn and garden only
		10 Monitoring well
		9 Dewatering
		12 Other (Specify below)

Was a chemical/bacteriological sample submitted to Department? Yes No **X** ; If yes, mo/day/yr sample was submitted

Water Well Disinfected? Yes No **X**

5 TYPE OF BLANK CASING USED:

1 Steel	3 RMP (SR)	5 Wrought iron	8 Concrete tile	CASING JOINTS: Glued X Clamped
2 PVC	4 ABS	6 Asbestos-Cement	9 Other (specify below)	Welded
		7 Fiberglass		Threaded

Blank casing diameter 1.6 in. to 9.8 ft., Dia in. to ft., Dia in. to ft.

Casing height above land surface 1.8 in., weight 16.15 lbs./ft. Wall thickness or gauge No. 50.0

TYPE OF SCREEN OR PERFORATION MATERIAL:

1 Steel	3 Stainless steel	5 Fiberglass	8 RMP (SR)	10 Asbestos-cement
2 Brass	4 Galvanized steel	6 Concrete tile	9 ABS	11 Other (specify)
				12 None used (open hole)

SCREEN OR PERFORATION OPENINGS ARE:

1 Continuous slot	3 Mill slot	5 Gauzed wrapped	8 Saw cut	11 None (open hole)
2 Louvered shutter	4 Key punched	6 Wire wrapped	9 Drilled holes	
		7 Torch cut	10 Other (specify)	

SCREEN-PERFORATED INTERVALS: From 9.8 ft. to 17.8 ft., From ft. to ft.

GRAVEL PACK INTERVALS: From 2.0 ft. to 17.8 ft., From ft. to ft.

6 GROUT MATERIAL: 1 Neat cement 2 Cement grout 3 Bentonite 4 Other

Grout intervals: From 0 ft. to 2.0 ft., From ft. to ft., From ft. to ft.

What is the nearest source of possible contamination: NONE

1 Septic tank	4 Lateral lines	7 Pit privy	10 Livestock pens	14 Abandoned water well
2 Sewer lines	5 Cess pool	8 Sewage lagoon	11 Fuel storage	15 Oil well/Gas well
3 Watertight sewer lines	6 Seepage pit	9 Feedyard	12 Fertilizer storage	16 Other (specify below)
			13 Insecticide storage	

Direction from well? How many feet?

FROM	TO	LITHOLOGIC LOG	FROM	TO	PLUGGING INTERVALS
0	2	Surface	115	121	Sandy Clay, Caliche & S.Sand
2	7	Loess	121	130	Fine to Med. Sand w/Clay
7	27	Med. Sand & Clay	130	134	Cemented Sand w/Clay&Caliche
27	32	Sandy Clay, Caliche & Sand	134	137	Med. Sand & Gravel
32	33	Caliche	137	145	Med.&Cemented Sand w/Caliche
33	52	Sandy Clay & Caliche & Sand			Strks. & S.Clay
52	58	Fine to Med Sand w/Clay & Cal.	145	150	Sandy Clay, Caliche/Sand Strk
58	60	Sandy Clay Caliche & Fine Sand	150	153	Fine to Med. Sand w/Clay St.
60	62	Cemented Sand w/Clay & Caliche	153	155	Cemented Sand w/Sand Strks.
62	65	Cemented Sand w/Sand Strks.	155	156	Fine to Med. Sand w/Clay Strk.
65	70	Fine Sand w/Clay & Caliche St.	156	160	Sticky Clay w/Some Sand
70	98	Sandy Clay & Caliche w/s.Sand	160	168	Fine to Med. Sand w/Clay Strk.
98	102	Fine to Med. Sand w/Clay&Cal.	168	178	Shale
102	110	Fine to Med. Sand w/Clay Ins.			
110	115	Med. Sand & Gravel w/s.Clay			

7 CONTRACTOR'S OR LANDOWNER'S CERTIFICATION: This water well was (1) constructed, (2) reconstructed, or (3) plugged under my jurisdiction and was completed on (mo/day/year) 6-24-94 and this record is true to the best of my knowledge and belief. Kansas Water Well Contractor's License No. 554 This Water Well Record was completed on (mo/day/yr) 7-1-94 under the business name of **Woofter Pump & Well, Inc.** by (signature) *[Signature]*

OFFICE USE ONLY
T
R
EW
SEC.
1/4
1/4
1/4