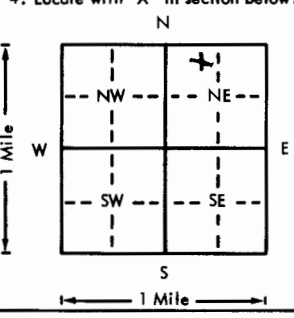


USE TYPEWRITER OR BALL POINT PEN—PRESS FIRMLY, PRINT CLEARLY.

WATER WELL RECORD
KSA 82a-1201-1215

Kansas Department of Health and Environment—Division of Environment
(Water well Contractors)
Topeka, Kansas 66620

1. Location of well:	County Shelby	Fraction NE 1/4 NW 1/4 NE 1/4	Section number 33	Township number T 9 S R 29	Range number 29
2. Distance and direction from nearest town or city: Street address of well location if in city:			3. Owner of well: Vernon Adams R.R. or street: City, state, zip code: Hoxie, Kansas 67740		
4. Locate with "X" in section below: 			Sketch map:		
5. Type and color of material			From	To	6. Bore hole dia. 8 in. Completion date 9-17-76 Well depth 180 ft.
Silt + clay			0	80	7. <input checked="" type="checkbox"/> Cable tool <input checked="" type="checkbox"/> Rotary <input type="checkbox"/> Driven <input type="checkbox"/> Dug <input type="checkbox"/> Hollow rod <input type="checkbox"/> Jetted <input type="checkbox"/> Bored <input type="checkbox"/> Reverse rotary
Sandstone + clay			80	115	8. Use: <input checked="" type="checkbox"/> Domestic <input type="checkbox"/> Public supply <input type="checkbox"/> Industry <input type="checkbox"/> Irrigation <input type="checkbox"/> Air conditioning <input type="checkbox"/> Stock <input type="checkbox"/> Lawn <input type="checkbox"/> Oil field water <input type="checkbox"/> Other
clay			115	120	9. Casing: Material plts Height: above or below Threaded <input type="checkbox"/> Welded <input checked="" type="checkbox"/> Surface 18 in. RMP <input type="checkbox"/> PVC <input checked="" type="checkbox"/> Weight _____ lbs./ft. Dia. 5 in. to 180 ft. depth Wall Thickness: inches or Dia. _____ in. to _____ ft. depth gage No. _____
Sand + gravel			120	160	<input checked="" type="checkbox"/> Screen: Manufacturer's name Peerless Plastics Pipe Type PVC Dia. 5 in. Slot/gauze 1/4 Length 20 ft Set between 150 ft. and 180 ft. _____ ft. and _____ ft. Gravel pack? yes Size range of material 1/4 down
Sand + clay			160	175	11. Static water level: _____ mo./day/yr. 96 ft. below land surface Date 9-17-76
Yellow clay			175	180	12. Pumping level below land surfaces: _____ ft. after _____ hrs. pumping _____ g.p.m. _____ ft. after _____ hrs. pumping _____ g.p.m. Estimated maximum yield 20 g.p.m.
					13. Water sample submitted: _____ mo./day/yr. <input type="checkbox"/> Yes <input checked="" type="checkbox"/> No Date _____
					14. Well head completion: <input type="checkbox"/> Pitless adapter _____ Inches above grade
					15. Well grouted? <input checked="" type="checkbox"/> With: clay cement <input type="checkbox"/> Bentonite <input type="checkbox"/> Concrete Depth: From 0 ft. to 20 ft.
					16. Nearest source of possible contamination: ft. _____ Direction _____ Type _____ Well disinfected upon completion? <input type="checkbox"/> Yes <input type="checkbox"/> No
					17. Pump: <input checked="" type="checkbox"/> Not installed Manufacturer's name _____ Model number _____ HP _____ Volts _____ Length of drop pipe _____ ft. capacity _____ g.p.m. Type: <input type="checkbox"/> Submersible <input type="checkbox"/> Turbine <input type="checkbox"/> Jet <input type="checkbox"/> Reciprocating <input type="checkbox"/> Centrifugal <input type="checkbox"/> Other
					(Use a second sheet if needed)
18. Elevation:	19. Remarks:		20. Water well contractor's certification: This well was drilled under my jurisdiction and this report is true to the best of my knowledge and belief. Agua Well Drilling 281 Business name License No. Address Gove, Kansas 67736 Signed J M Little Date 6-20-77 Authorized representative		
Topography: <input type="checkbox"/> Hill <input type="checkbox"/> Slope <input checked="" type="checkbox"/> Upland <input type="checkbox"/> Valley					

Forward the white, blue and pink copies to the Department of Health and Environment

Form WWC-5