WATER WELL RECORD Form WWC-5 KSA 82a-1212

1 LOCATION OF WATER WELL: County: SHERIDAN | Fraction: SE ¼ NW ¼ NW ¼ | Section Number: 2 | Township Number: T 9 S | Range Number: R 29 (E) W

Distance and direction from nearest town or city street address of well if located within city?
5 S 5 W OF HOXIE

2 WATER WELL OWNER: ELM, INC
RR#, St. Address, Box # : RT 1, BOX 31
City, State, ZIP Code : MENLO, KS
Board of Agriculture, Division of Water Resources
Application Number:

3 LOCATE WELL'S LOCATION WITH AN "X" IN SECTION BOX:

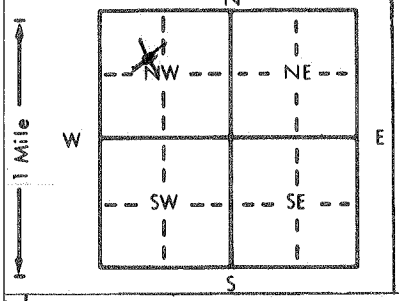

4 DEPTH OF COMPLETED WELL. . . UNK . . . ft. ELEVATION:
Depth(s) Groundwater Encountered 1. . . . . ft. 2. . . . . ft. 3. . . . . ft.
WELL'S STATIC WATER LEVEL . . UNK . . ft. below land surface measured on mo/day/yr . . . . . .
Pump test data: Well water was . . . . . ft. after . . . . . hours pumping . . . . . gpm
Est. Yield . . . . . gpm: Well water was . . . . . ft. after . . . . . hours pumping . . . . . gpm
Bore Hole Diameter . . . . . in. to . . . . . ft., and . . . . . in. to . . . . . ft.
WELL WATER TO BE USED AS: 5 Public water supply 8 Air conditioning 11 Injection well
(1) Domestic 3 Feedlot 6 Oil field water supply 9 Dewatering 12 Other (Specify below)
2 Irrigation 4 Industrial 7 Lawn and garden only 10 Monitoring well . . . . . .
Was a chemical/bacteriological sample submitted to Department? Yes . . . . . No . . . . . ; If yes, mo/day/yr sample was submitted
Water Well Disinfected? Yes No

5 TYPE OF BLANK CASING USED: 5 Wrought iron 8 Concrete tile CASING JOINTS: Glued . . . . . Clamped . . . . .
(1 Steel) 3 RMP (SR) 6 Asbestos-Cement 9 Other (specify below) Welded . . . . . .
2 PVC 4 ABS 7 Fiberglass . . . . . Threaded . . . . . .
Blank casing diameter . . . 5" . . . . . in. to . . . . . ft., Dia . . . . . in. to . . . . . ft., Dia . . . . . in. to . . . . . ft.
Casing height above land surface . . . . . in., weight . . . . . lbs./ft. Wall thickness or gauge No. . . . . .
TYPE OF SCREEN OR PERFORATION MATERIAL: UNK 7 PVC 10 Asbestos-cement
1 Steel 3 Stainless steel 5 Fiberglass 8 RMP (SR) 11 Other (specify) . . . . . .
2 Brass 4 Galvanized steel 6 Concrete tile 9 ABS 12 None used (open hole)
SCREEN OR PERFORATION OPENINGS ARE: UNK 5 Gauzed wrapped 8 Saw cut 11 None (open hole)
1 Continuous slot 3 Mill slot 6 Wire wrapped 9 Drilled holes
2 Louvered shutter 4 Key punched 7 Torch cut 10 Other (specify) . . . . . .
SCREEN-PERFORATED INTERVALS: From . . . . . ft. to . . . . . ft., From . . . . . ft. to . . . . . ft.
From . . . . . ft. to . . . . . ft., From . . . . . ft. to . . . . . ft.
GRAVEL PACK INTERVALS: From . . . . . ft. to . . . . . ft., From . . . . . ft. to . . . . . ft.
From ft. to ft., From ft. to ft.

6 GROUT MATERIAL: UNK ~~Neat~~ cement (2) Cement grout 3 Bentonite 4 Other . . . . . .
Grout Intervals: From . . . 5 . . . ft. to . . . 0 . . . ft., From . . . . . ft. to . . . . . ft., From . . . . . ft. to . . . . . ft.
What is the nearest source of possible contamination:
1 Septic tank 4 Lateral lines 7 Pit privy 10 Livestock pens 14 Abandoned water well
2 Sewer lines 5 Cess pool 8 Sewage lagoon 11 Fuel storage 15 Oil well/Gas well
3 Watertight sewer lines 6 Seepage pit 9 Feedyard 12 Fertilizer storage (16) Other (specify below)
13 Insecticide storage . . . . . NONE . . . . . .
Direction from well? How many feet?

FROM	TO	LITHOLOGIC LOG	FROM	TO	PLUGGING INTERVALS
BOTTOM	5' BLS	DIRT			
5' BLS	TOP OF CASING		CEMENT		
CEMENT AROUND CASING					

7 CONTRACTOR'S OR LANDOWNER'S CERTIFICATION: This water well was (1) constructed, (2) reconstructed, or (3) plugged under my jurisdiction and was completed on (mo/day/year) . . . JUNE 6, 1988 . . . and this record is true to the best of my knowledge and belief. Kansas Water Well Contractor's License No. . . . . This Water Well Record was completed on (mo/day/yr) . . . JUNE 27, 1988 . . . under the business name of ELM INC by (signature) E. L. Inc Cornish Pres.

INSTRUCTIONS: Use typewriter or ball point pen. *PLEASE PRESS FIRMLY* and *PRINT* clearly. Please fill in blanks, underline or circle the correct answers. Send top three copies to Kansas Department of Health and Environment, Bureau of Water Protection, Topeka, Kansas 66620-7320. Telephone: 913-296-5514. Send one to WATER WELL OWNER and retain one for your records.