


1 LOCATION OF WATER WELL: Fraction SW 1/4 NE 1/4 SW 1/4 Section Number 6 Township Number T 9 S Range Number R 29 EW

Distance and direction from nearest town or city street address of well if located within city?  
3 Miles South 1/2 West of Seguin, Kansas

2 WATER WELL OWNER: Brian Baalman  
RR#, St. Address, Box # :  
City, State, ZIP Code : Menlo, Ks. 67746  
Board of Agriculture, Division of Water Resource  
Application Number: 19,490

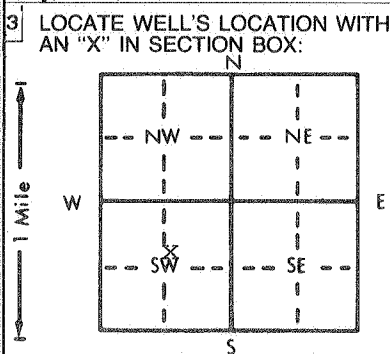

4 DEPTH OF COMPLETED WELL... 215 ft. ELEVATION:  
Depth(s) Groundwater Encountered 1. ft. 2. ft. 3. ft.  
WELL'S STATIC WATER LEVEL... 123 ft. below land surface measured on mo/day/yr 12-7-88  
Pump test data: Well water was ft. after hours pumping gpm  
Est. Yield 70.0 gpm: Well water was ft. after hours pumping gpm  
Bore Hole Diameter 2.8 in. to 2.15 ft., and in. to ft.  
WELL WATER TO BE USED AS: 5 Public water supply 8 Air conditioning 11 Injection well  
1 Domestic 3 Feedlot 6 Oil field water supply 9 Dewatering 12 Other (Specify below)  
2 Irrigation 4 Industrial 7 Lawn and garden only 10 Monitoring well  
Was a chemical/bacteriological sample submitted to Department? Yes.....No...X.....; If yes, mo/day/yr sample was submitted Water Well Disinfected? Yes No X

5 TYPE OF BLANK CASING USED: 5 Wrought iron 8 Concrete tile CASING JOINTS: Glued X Clamped  
1 Steel 3 RMP (SR) 6 Asbestos-Cement 9 Other (specify below) Welded  
2 PVC 4 ABS 7 Fiberglass Threaded  
Blank casing diameter 16 in. to 1.35 ft., Dia in. to ft., Dia in. to ft.  
Casing height above land surface 16 in., weight lbs./ft. Wall thickness or gauge No.

TYPE OF SCREEN OR PERFORATION MATERIAL: 7 PVC 10 Asbestos-cement  
1 Steel 3 Stainless steel 5 Fiberglass 8 RMP (SR) 11 Other (specify)  
2 Brass 4 Galvanized steel 6 Concrete tile 9 ABS 12 None used (open hole)

SCREEN OR PERFORATION OPENINGS ARE: 5 Gauzed wrapped 8 Saw cut 11 None (open hole)  
1 Continuous slot 3 Mill slot 6 Wire wrapped 9 Drilled holes  
2 Louvered shutter 4 Key punched 7 Torch cut 10 Other (specify)

SCREEN-PERFORATED INTERVALS: From 135 ft. to 215 ft., From ft. to ft.  
GRAVEL PACK INTERVALS: From 20 ft. to 215 ft., From ft. to ft.

6 GROUT MATERIAL: 1 Neat cement 2 Cement grout 3 Bentonite 4 Other  
Grout intervals: From 0 ft. to 20 ft., From ft. to ft., From ft. to ft.  
What is the nearest source of possible contamination: 10 Livestock pens 14 Abandoned water well  
1 Septic tank 4 Lateral lines 7 Pit privy 11 Fuel storage 15 Oil well/Gas well  
2 Sewer lines 5 Cess pool 8 Sewage lagoon 12 Fertilizer storage 16 Other (specify below)  
3 Watertight sewer lines 6 Seepage pit 9 Feedyard 13 Insecticide storage  
Direction from well? East How many feet? 800

| FROM | TO  | LITHOLOGIC LOG | FROM | TO  | PLUGGING INTERVALS |
|------|-----|----------------|------|-----|--------------------|
| 0    | 3   | Surface        | 174  | 177 | Sandy clay         |
| 3    | 31  | Clay           | 177  | 179 | Clay               |
| 31   | 63  | Med sand       | 179  | 184 | Cemented sand      |
| 63   | 72  | Caliche        | 184  | 195 | Clay               |
| 72   | 81  | Med. sand      | 195  | 197 | Caliche            |
| 81   | 90  | Caliche        | 197  | 201 | Med. sand          |
| 90   | 106 | Med. sand      | 201  | 202 | Cemented streak    |
| 106  | 118 | Clay           | 202  | 212 | Med. sand          |
| 118  | 121 | Cemented sand  | 212  | 215 | Ochre              |
| 121  | 129 | Sandy clay     |      |     |                    |
| 129  | 134 | Caliche        |      |     |                    |
| 134  | 145 | Med sand       |      |     |                    |
| 145  | 150 | Clay           |      |     |                    |
| 150  | 156 | Caliche        |      |     |                    |
| 156  | 174 | Med. sand      |      |     |                    |

7 CONTRACTOR'S OR LANDOWNER'S CERTIFICATION: This water well was (1) constructed, (2) reconstructed, or (3) plugged under my jurisdiction and was completed on (mo/day/year) 12-7-88 and this record is true to the best of my knowledge and belief. Kansas Water Well Contractor's License No. 394 This Water Well Record was completed on (mo/day/yr) 3-16-89 under the business name of Woofter Pump & Well by (signature) Walt Woofter