

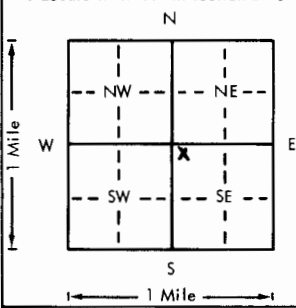
USE TYPEWRITER OR BALL POINT PEN-PRESS FIRMLY, PRINT CLEARLY.

SEQUIN

WATER WELL RECORD  
KSA 82a-1201-1215

Kansas Department of Health and Environment-Division of Environment  
(Water well Contractors)  
Topeka, Kansas 66620

DBB

1. Location of well:		County <b>Sheridan</b>	Fraction <b>NW 1/4 NW 1/4 SE 1/4</b>	Section number <b>12</b>	Township number <b>T 9 S R 29</b>	Range number <b>17W</b>
2. Distance and direction from nearest town or city: <b>Hoxie, Kansas</b> <b>4 1/2 mi. South; 3 1/2 mi. West</b> Street address of well location if in city:			3. Owner of well: <b>Bill Patmon</b> R.R. or street: City, state, zip code: <b>Hoxie, Kansas 67701</b>			
4. Locate with "X" in section below: 			Sketch map:			6. Bore hole dia. <b>30</b> in. Completion date <b>11-2-78</b> Well depth <b>87</b> ft.
5. Type and color of material			From	To	7. <input type="checkbox"/> Cable tool <input type="checkbox"/> Rotary <input type="checkbox"/> Driven <input type="checkbox"/> Dug <input type="checkbox"/> Hollow rod <input type="checkbox"/> Jetted <input type="checkbox"/> Bored <input checked="" type="checkbox"/> Reverse rotary	
Top Soil			0	6	8. Use: <input type="checkbox"/> Domestic <input type="checkbox"/> Public supply <input type="checkbox"/> Industry <input checked="" type="checkbox"/> Irrigation <input type="checkbox"/> Air conditioning <input type="checkbox"/> Stock <input type="checkbox"/> Lawn <input type="checkbox"/> Oil field water <input type="checkbox"/> Other	
Medium Gravel & Gravel			6	20	9. Casing: Material <b>Steel</b> Height: Above or below Threaded <input type="checkbox"/> Welded <input checked="" type="checkbox"/> Surface <b>12</b> in. RMP <input type="checkbox"/> PVC <input type="checkbox"/> Weight <b>31.75</b> lbs./ft. Dia. <b>16</b> in. to <b>87</b> ft. depth Wall Thickness: inches or Dia. <input type="checkbox"/> in. to <input type="checkbox"/> ft. depth gage No. <b>188</b>	
Fine Sand & Medium Gravel			20	27	10. Screen: Manufacturer's name <b>Cook</b> Type <b>Wire Wrapped</b> Dia. <b>16</b> Slot/gauze <b>100</b> Length <b>10</b> Set between <b>77</b> ft. and <b>87</b> ft. Gravel pack? <input checked="" type="checkbox"/> Size range of material <b>30% #1, 70% #20</b>	
Clay			27	37	11. Static water level: <input type="checkbox"/> mo./day/yr. <b>9</b> ft. below land surface Date <b>11-3-78</b>	
Fine Sand & Medium Gravel			37	41	12. Pumping level below land surfaces: <b>83</b> ft. after <b>2</b> hrs. pumping <b>520</b> g.p.m. <input type="checkbox"/> ft. after <input type="checkbox"/> hrs. pumping <input type="checkbox"/> g.p.m. Estimated maximum yield <b>520</b> g.p.m.	
Medium Gravel & Streaks for Sandstone (Hard)			41	49	13. Water sample submitted: <input type="checkbox"/> mo./day/yr. Yes <input checked="" type="checkbox"/> No Date <input type="checkbox"/>	
Clay & Streaks of Sandstone			49	65	14. Well head completion: <input type="checkbox"/> Pitless adapter <b>12</b> Inches above grade	
Fine Sand & Medium Gravel (Trace of Clay-White)			65	76	15. Well grouted? <input checked="" type="checkbox"/> With: <input type="checkbox"/> Neat cement <input type="checkbox"/> Bentonite <input checked="" type="checkbox"/> Concrete Depth: From <b>0</b> ft. to <b>10</b> ft.	
Clay			76	84	16. Nearest source of possible contamination: ft. <b>800</b> Direction <b>NNW</b> Type <b>Farmstead</b> Well disinfected upon completion? Yes <input checked="" type="checkbox"/> No	
Medium Gravel & Fine Sand (White)			84	90	17. Pump: <input type="checkbox"/> Not installed Manufacturer's name <b>Western Land Roller</b> Model number <b>10 CH</b> HP <b>50</b> Volts <input type="checkbox"/> Length of drop pipe <b>86</b> ft. capacity <b>500</b> g.p.m. Type: <input type="checkbox"/> Submersible <input checked="" type="checkbox"/> Turbine <input type="checkbox"/> Jet <input type="checkbox"/> Reciprocating <input type="checkbox"/> Centrifugal <input type="checkbox"/> Other	
Ochre & Blue Shale			90	100	20. Water well contractor's certification: This well was drilled under my jurisdiction and this report is true to the best of my knowledge and belief. <b>Western Well &amp; Pump, Inc 245</b> Business name <b>Box 852 Colby, KS</b> License No. <b>67701</b> Address <b>DB Patmon</b> Date <b>12-6-78</b> Signed <b>DB Patmon</b> Authorized representative	
(Use a second sheet if needed)						
18. Elevation:  Topography: <input type="checkbox"/> Hill <input type="checkbox"/> Slope <input type="checkbox"/> Upland <input checked="" type="checkbox"/> Valley	19. Remarks: <b>Creek bottom well - first flood plain casing raised approx. 2 feet.</b> <b>2700 (top)</b>					

T 9  
 R 29  
 S  
 W 17  
 Sec 12  
 NW 1/4 SE 1/4

Forward the white, blue and pink copies to the Department of Health and Environment

Form WWC-5