MENLO SE

USE TYPEWRITER OR BALL POINT PEN-PRESS FIRMLY, PRINT CLEARLY.

T R EW sec 1/4 1/4 1/4 No.

WATER WELL RECORD
KSA 82a-1201-1215

ABD

Kansas State Dept. Of Health
(Water Well Contractors)
Forbes-Bldg. 740
Topeka, Kansas 66620

1 Location of well:	County	Township name	Fraction	Section number	Town number	Range number
	Sheridan.	9	SE-NW-NE	17	9S	29 W

Distance and direction from nearest town or city: 4 South ½ East of Seguin.

Street address of well location if in city:

3 Owner of well: Ray Bange

Address: Menlo

Locate with "X" in section below:

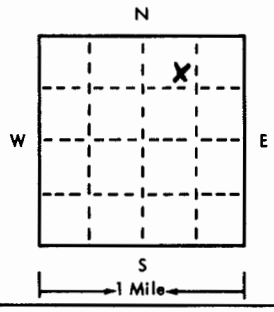

Sketch map:

4 Well depth: 167 ft. Date of completion 1-2-75
Well diameter 28 in.

5 ☐ Cable tool ☐ Rotary ☐ Driven ☐ Dug
☐ Hollow rod ☐ Jetted ☐ Bored ☒ Reverse rotary

6 Use: ☐ Domestic ☐ Public supply ☐ Industry
☒ Irrigation ☐ Air conditioning ☐ Commercial
☐ Test well ☐

7 Casing: Material Steel Height: above/below
Threaded ☐ Welded ☒ Surface ___ in.
Diam. Weight ___ lbs./ft.
12¾ in. to 97 ft. depth Drive shoe? ☐ Yes ☒ No
___ in. to ___ ft. depth

2

Type and color of material	From	To
Medium Gravel & Sand Stone - (Brown)	74	87
Sandy Clay	87	94
Medium Gravel - (Brown)	94	108
Sandy Clay	108	112
Medium Gravel (Brown)	112	117
Sandy Clay	117	120
Medium Gravel (Brown)	120	125
Sandy Clay & Sand Stone - (Brown)	125	128
Clay	128	147
Medium Gravel + Traces of Sandy Clay	147	159
Ochre & Shale - (Yellow & Blue)	159	167
BROCK 159'		
(use a second sheet if needed)		

8 Screen:
Manufacturer
Type Slot Dia. 12¾
Slot/gauze Length
Set between 97 ft. and 167 ft.
Fittings:
Gravel pack ☒ Yes ☐ No Size range of material

9 Static water level:
26 ft. below land surface Date 1-2-75

10 Pumping level below land surfaces:
159 ft. after 7 hrs. pumping 625 g.p.m.
___ ft. after ___ hrs. pumping ___ g.p.m.
Estimated maximum yield 625 g.p.m.

11 Water sample submitted:
☐ Yes ☒ No Date

12 Well head completion:
☐ Pitless adapter 12 Inches above grade

13 Well grouted? ☐ Yes ☒ No
☐ Neat cement ☐ Bentonite ☐
Depth: From ___ ft. to ___ ft.

14 Nearest source of possible contamination:
ft. 2640 Direction SW Type Sewer
Well disinfected upon completion? ☐ Yes ☒ No

15 Pump: ☐ Not installed
Manufacturer's name Simonds
Model number HP 25 Volts 440
Length of drop pipe 150 ft. capacity 600 g.m.p.
Type:
☐ Submersible ☒ Turbine
☐ Jet ☐ Reciprocating
☐ Certrifugal ☐ Other

16 Remarks: elevation

2829 (TOPO)

Topography:
☐ Hill
☒ Slope
☐ Upland
☐ Valley

17 Water well contractor's certification:
This well was drilled under my jurisdiction and this report is true to the best of my knowledge and belief.
Red Tiger Inc 125
Business name License No.
Address Colby Ks. Box 388 - 67701
Signed Dan Hamm Date 1-29-75
Authorized representative

Forward the white, blue and pink copies to the Kansas State Dept. Of Health.

Form WWC-5

677-H