


1 LOCATION OF WATER WELL: Fraction $\frac{SW}{4}$ $\frac{SW}{4}$ $\frac{SW}{4}$ Section Number 25 Township Number T 9 S Range Number R 29 W E/W
 County: Sheridan
 Distance and direction from nearest town or city street address of well if located within city?

N/A - LOCATION CONFIRMED BY GMD #4

2 WATER WELL OWNER: Bernita Lundgren
 RR#, St. Address, Box #: 8380 Greensboro Drive Board of Agriculture, Division of Water Resources
 City, State, ZIP Code: McLean, VA 22102 Application Number:

3 LOCATE WELL'S LOCATION WITH AN "X" IN SECTION BOX:

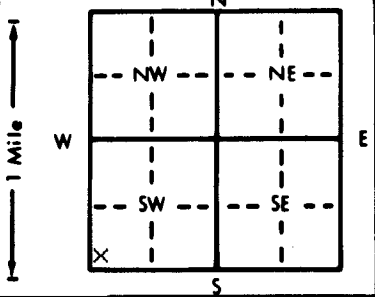

4 DEPTH OF COMPLETED WELL: 92 ft. ELEVATION: well 119 ft deep covered @ 92 ft.
 Depth(s) Groundwater Encountered 1. ft. 2. ft. 3. ft.
 WELL'S STATIC WATER LEVEL: 90 ft. below land surface measured on mo/day/yr 4-23-90
 Pump test data: Well water was ft. after hours pumping gpm
 Est. Yield gpm: Well water was ft. after hours pumping gpm
 Bore Hole Diameter. in. to ft., and in. to ft.
 WELL WATER TO BE USED AS:
 X1 Domestic 3 Feedlot 6 Oil field water supply 9 Dewatering 12 Other (Specify below)
 2 Irrigation 4 Industrial 7 Lawn and garden only 10 Monitoring well
 Was a chemical/bacteriological sample submitted to Department? Yes. No.; If yes, mo/day/yr sample was submitted
 Water Well Disinfected? Yes No

5 TYPE OF BLANK CASING USED:
 X1 Steel 3 RMP (SR) 5 Wrought iron 8 Concrete tile CASING JOINTS: Glued Clamped
 2 PVC 4 ABS 6 Asbestos-Cement 9 Other (specify below) Welded
 7 Fiberglass Threaded

Blank casing diameter . . . 5 in. to ft., Dia in. to ft., Dia in. to ft.
 Casing height above land surface . . . 10 in., weight lbs./ft. Wall thickness or gauge No.

TYPE OF SCREEN OR PERFORATION MATERIAL:
 1 Steel 3 Stainless steel 5 Fiberglass 7 PVC 10 Asbestos-cement
 2 Brass 4 Galvanized steel 6 Concrete tile 8 RMP (SR) 11 Other (specify)
 9 ABS 12 None used (open hole)

SCREEN OR PERFORATION OPENINGS ARE:
 1 Continuous slot 3 Mill slot 5 Gauzed wrapped 8 Saw cut 11 None (open hole)
 2 Louvered shutter 4 Key punched 6 Wire wrapped 9 Drilled holes
 7 Torch cut 10 Other (specify)

SCREEN-PERFORATED INTERVALS: From ft. to ft., From ft. to ft.
 From ft. to ft., From ft. to ft.
 GRAVEL PACK INTERVALS: From ft. to ft., From ft. to ft.
 From ft. to ft., From ft. to ft.

6 GROUT MATERIAL: 1 Neat cement 2 Cement grout 3 Bentonite 4 Other
 Grout Intervals: From ft. to ft., From ft. to ft., From ft. to ft.

What is the nearest source of possible contamination:
 1 Septic tank 4 Lateral lines 7 Pit privy 10 Livestock pens 14 Abandoned water well
 2 Sewer lines 5 Cess pool 8 Sewage lagoon 11 Fuel storage 15 Oil well/Gas well
 3 Watertight sewer lines 6 Seepage pit 9 Feedyard 12 Fertilizer storage 16 Other (specify below)
 13 Insecticide storage
 Direction from well? How many feet?

| FROM | TO | LITHOLOGIC LOG | FROM | TO | PLUGGING INTERVALS |
|------|-------------|----------------|------|----|-------------------------------------|
| | ENTER | | | | REMOVED UPPER 4 FT. OF STEEL CASING |
| | | | 92 | 85 | SAND |
| | PLUGGING | | 85 | 6 | CLAY |
| | | | 6 | 3 | CEMENT |
| | | | 3 | 0 | SURFACE CLAY |
| | INFORMATION | | | | |
| | AT | | | | |
| | RIGHT | | | | |

RECEIVED

JUN 18 1990

DIVISION OF ENVIRONMENT

7 CONTRACTOR'S OR LANDOWNER'S CERTIFICATION: This water well was 1) constructed, 2) reconstructed, or 3) plugged under my jurisdiction and was completed on (mo/day/year) 4-23-90 and this record is true to the best of my knowledge and belief. Kansas Water Well Contractor's License No. This Water Well Record was completed on (mo/day/yr) 4-23-90 under the business name of by (signature) *W. Francis F. O'Brien*

OFFICE USE ONLY
T
R
EW
SEC.
1/4
1/4
1/4