

WATER WELL RECORD

Form WWC-5


Division of Water Resources App. No.

1 LOCATION OF WATER WELL: Fraction NW 1/4 NE 1/4 NE 1/4 NW 1/4 Section Number 24 Township No. T 9 S Range Number R 3 E W
 County: OTTAWA

Street/Rural Address of Well Location; if unknown, distance & direction from nearest town or intersection: If at owner's address, check here
1/2 MILE EAST OF INTERSECTION UTE RD. ADD 170th RD. SOUTH SIDE

Global Positioning System (GPS) information:
 Latitude: (in decimal degrees)
 Longitude: (in decimal degrees)
 Elevation:
 Datum: WGS 84, NAD 83, NAD 27
Collection Method:
 GPS unit (Make/Model:)
 Digital Map/Photo, Topographic Map, Land Survey
 Est. Accuracy: <3 m, 3-5 m, 5-15 m, >15 m

2 WATER WELL OWNER: DENNIS ADLARD
 RR#, Street Address, Box #: 2134 N. 90th RD.
 City, State, ZIP Code: DELPHOS, MO 67436

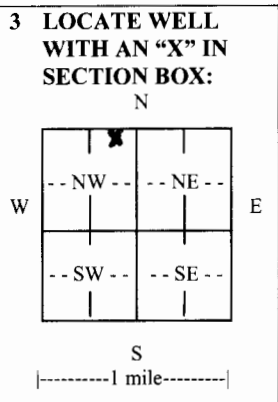

4 DEPTH OF COMPLETED WELL 147 ft.
 Depth(s) Groundwater Encountered (1) 110 ft. (2) ft. (3) ft.
 WELL'S STATIC WATER LEVEL 85 ft. below land surface measured on mo/day/yr 07-15-11
 Pump test data: Well water was ft. after hours pumping gpm
 EST. YIELD gpm. Well water was ft. after hours pumping gpm
 Bore Hole Diameter 9 in. to 150 ft., and in. to ft.
 WELL WATER TO BE USED AS: Public water supply Geothermal Injection well
 Domestic Feedlot Oil field water supply Dewatering Other (Specify below)
 Irrigation Industrial Domestic-lawn & garden Monitoring well
 Was a chemical/bacteriological sample submitted to Department? Yes No
 If yes, mo/day/yr sample was submitted.....
 Water well disinfected? Yes No

5 TYPE OF CASING USED: Steel PVC Other
 CASING JOINTS: Glued Clamped Welded Threaded
 Casing diameter 5 in. to 12.7 ft., Diameter in. to ft., Diameter in. to ft.
 Casing height above land surface 20 in., Weight 160 lbs./ft., Wall thickness or gauge No. SDR 26
 TYPE OF SCREEN OR PERFORATION MATERIAL:
 Steel Stainless Steel PVC Other (Specify)
 Brass Galvanized Steel None used (open hole)
 SCREEN OR PERFORATION OPENINGS ARE:
 Continuous slot Mill slot, 0.25 Gauze wrapped Torch cut Drilled holes None (open hole)
 Louvered shutter Key punched Wire wrapped Saw cut Other (specify)
 SCREEN-PERFORATED INTERVALS: From 1.27 ft. to 147 ft., From ft. to ft.
 From ft. to ft., From ft. to ft.
 GRAVEL PACK INTERVALS: From 1.00 ft. to 147 ft., From ft. to ft.
 From ft. to ft., From ft. to ft.

6 GROUT MATERIAL: Neat cement Cement grout Bentonite Other
 Grout Intervals: From 0 ft. to 20 ft., From 94 ft. to 100 ft., From ft. to ft.
 What is the nearest source of possible contamination:
 Septic tank Lateral lines Pit privy Livestock pens Insecticide storage Other (specify below)
 Sewer lines Cesspool Sewage lagoon Fuel storage Abandoned water well
 Watertight sewer lines Seepage pit Feedyard Fertilizer storage Oil well/gas well
 Direction from well Distance from well OPEN PASTURE NONE APPARENT

FROM	TO	LITHOLOGIC LOG	FROM	TO	LITHO. LOG (cont.) or PLUGGING INTERVALS
<u>0</u>	<u>2</u>	<u>TOPSOIL</u>			
<u>2</u>	<u>18</u>	<u>CLAY BROWN</u>			
<u>18</u>	<u>42</u>	<u>BRECK GRAVEL BROWN WITH LAYERS OF CLAY TAN</u>			
<u>42</u>	<u>110</u>	<u>CLAY AND SHALE MULTI COLORED</u>			
<u>110</u>	<u>150</u>	<u>SANDSTONE TAN FINE GRAIN</u>			

7 CONTRACTOR'S OR LANDOWNER'S CERTIFICATION: This water well was constructed, reconstructed, or plugged under my jurisdiction and was completed on (mo/day/year) 07-15-11 and this record is true to the best of my knowledge and belief. Kansas Water Well Contractor's License No. 305 This Water Well Record was completed on (mo/day/year) 07-15-11 under the business name of PE STINGERS PUMP SER. by (signature) Paul Stelling

INSTRUCTIONS: Use typewriter or ball point pen. PLEASE PRESS FIRMLY and PRINT clearly. Please fill in blanks and check the correct answers. Send three copies (white, blue, pink) to Kansas Department of Health and Environment, Bureau of Water, Geology Section, 1000 SW Jackson St., Suite 420, Topeka, Kansas 66612-1367. Telephone 785-296-5524. Send one copy to WATER WELL OWNER and retain one for your records. Include fee of \$5.00 for each constructed well. Visit us at <http://www.kdheks.gov/waterwell/index.html>.