


1 LOCATION OF WATER WELL: Fraction NW 1/4 SW 1/4 SW 1/4 Section Number 5 Township Number T 9 S Range Number R 30 E  
 County: Sheridan

Distance and direction from nearest town or city street address of well if located within city?  
N/A location confirmed by Gmp#4

2 WATER WELL OWNER: Donald L. Schultz  
 RR#, St. Address, Box #: RR2 Box 29 Board of Agriculture, Division of Water Resources  
 City, State, ZIP Code: Grainfield, KS Application Number:

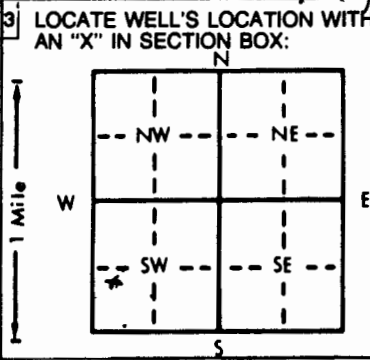

4 DEPTH OF COMPLETED WELL... unk ft. ELEVATION: .....  
 Depth(s) Groundwater Encountered 1. None ft. 2. .... ft. 3. .... ft.  
 WELL'S STATIC WATER LEVEL ..... ft. below land surface measured on mo/day/yr .....  
 Pump test data: Well water was ..... ft. after ..... hours pumping ..... gpm  
 Est. Yield ..... gpm: Well water was ..... ft. after ..... hours pumping ..... gpm  
 Bore Hole Diameter ..... in. to ..... ft., and ..... in. to ..... ft.  
 WELL WATER TO BE USED AS:  
 Domestic    3 Feedlot    6 Oil field water supply    9 Dewatering    12 Other (Specify below)  
 Irrigation    4 Industrial    7 Lawn and garden only    10 Monitoring well    Dry Abandoned  
 Was a chemical/bacteriological sample submitted to Department? Yes.....No.....; If yes, mo/day/yr sample was submitted  
 Water Well Disinfected? Yes    No


5 TYPE OF BLANK CASING USED:  
 Steel    3 RMP (SR)    5 Wrought iron    8 Concrete tile    CASING JOINTS: Glued ..... Clamped .....  
 PVC    4 ABS    6 Asbestos-Cement    9 Other (specify below)    Welded .....  
 Fiberglass    .....    Threaded.....  
 Blank casing diameter ..... in. to ..... ft., Dia ..... in. to ..... ft., Dia ..... in. to ..... ft.  
 Casing height above land surface ..... in., weight ..... lbs./ft. Wall thickness or gauge No. ....

TYPE OF SCREEN OR PERFORATION MATERIAL:  
 Steel    3 Stainless steel    5 Fiberglass    8 RMP (SR)    10 Asbestos-cement  
 Brass    4 Galvanized steel    6 Concrete tile    9 ABS    11 Other (specify) .....  
 Screen or perforation openings are:  
 Continuous slot    3 Mill slot    5 Gauzed wrapped    8 Saw cut    11 None (open hole)  
 Louvered shutter    4 Key punched    6 Wire wrapped    9 Drilled holes  
 Torch cut    10 Other (specify) .....

SCREEN-PERFORATED INTERVALS: From ..... ft. to ..... ft., From ..... ft. to ..... ft.  
 GRAVEL PACK INTERVALS: From ..... ft. to ..... ft., From ..... ft. to ..... ft.  
 From ..... ft. to ..... ft., From ..... ft. to ..... ft.

6 GROUT MATERIAL:  Neat cement    2 Cement grout    3 Bentonite    4 Other .....  
 Grout Intervals: From 6 ft. to 3 ft., From ..... ft. to ..... ft., From ..... ft. to ..... ft.  
 What is the nearest source of possible contamination:  
 Septic tank    4 Lateral lines    7 Pit privy    10 Livestock pens    14 Abandoned water well  
 Sewer lines    5 Cess pool    8 Sewage lagoon    11 Fuel storage    15 Oil well/Gas well  
 Watertight sewer lines    6 Seepage pit    9 Feedyard    12 Fertilizer storage    16 Other (specify below)  
 13 Insecticide storage .....  
 Direction from well?    How many feet?

FROM	TO	LITHOLOGIC LOG	FROM	TO	PLUGGING INTERVALS
		<u>4" Casing WAS open</u>	<u>20'</u>	<u>Top</u>	<u>filled with sand</u>
			<u>6</u>	<u>3</u>	<u>Cement</u>
			<u>3</u>	<u>0</u>	<u>top soil</u>

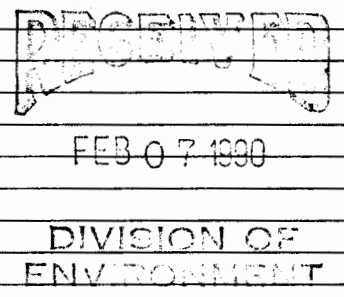

7 CONTRACTOR'S OR LANDOWNER'S CERTIFICATION: This water well was (1) constructed, (2) reconstructed, or (3) plugged under my jurisdiction and was completed on (mo/day/year) 7 - 14 - 89 and this record is true to the best of my knowledge and belief. Kansas Water Well Contractor's License No. .... This Water Well Record was completed on (mo/day/yr) ..... under the business name of ..... by (signature) Donald L. Schultz