

1	LOCATION OF WATER WELL: County: Thomas	Fraction E/2 1/4 NE 1/4 NE 1/4	Section Number 5	Township Number T 9 S	Range Number R 31 W E/W
---	---	---	---------------------	------------------------------	----------------------------------

Distance and direction from nearest town or city street address of well if located within city?


Jct. I70 & 83 hwy, 8 N, 4 E, 1/8 S, W into

~~DDRX980X88~~

2 WATER WELL OWNER:		CARR 1-5
RR#, St. Address, Box # :	White & Ellis Drilling, Inc.	Board of Agriculture, Division of Water Resources
City, State, ZIP Code :	P. O. Box 1586, Great Bend, KS 67530	Application Number: 960162

3 LOCATE WELL'S LOCATION WITH AN "X" IN SECTION BOX:

4 DEPTH OF COMPLETED WELL.....186..... ft. ELEVATION:

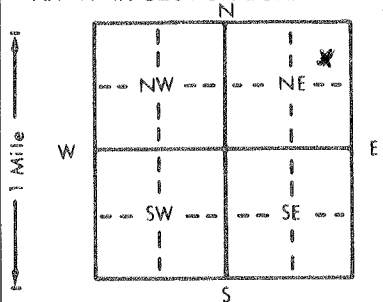

Depth(s) Groundwater Encountered 1. ft. 2. ft. 3. ft.

WELL'S STATIC WATER LEVEL ft. below land surface measured on mo/day/yr

Pump test data: Well water was ft. after hours pumping gpm

Est. Yield gpm: Well water was ft. after hours pumping gpm

Bore Hole Diameter in. to ft., and in. to ft.

WELL WATER TO BE USED AS:

5 Public water supply	8 Air conditioning	11 Injection well
① Domestic	3 Feedlot	6 Oil field water supply
		9 Dewatering
		12 Other (Specify below)
2 Irrigation	4 Industrial	7 Lawn and garden only
		10 Monitoring well

Was a chemical/bacteriological sample submitted to Department? Yes.....No.....; If yes, mo/day/yr sample was submitted

Water Well Disinfected? Yes No

5] TYPE OF BLANK CASING USED:		5 Wrought iron	8 Concrete tile	CASING JOINTS: Glued Clamped	
1 Steel	3 RMP (SR)	6 Asbestos-Cement	9 Other (specify below)	Welded	
2 PVC	4 ABS	7 Fiberglass		Threaded.	
Blank casing diameter in. to ft., Dia in. to ft., Dia in. to ft.					
Casing height above land surface. in., weight lbs./ft. Wall thickness or gauge No.					
TYPE OF SCREEN OR PERFORATION MATERIAL:			7 PVC	10 Asbestos-cement	
1 Steel	3 Stainless steel	5 Fiberglass	8 RMP (SR)	11 Other (specify)	
2 Brass	4 Galvanized steel	6 Concrete tile	9 ABS	12 None used (open hole)	
SCREEN OR PERFORATION OPENINGS ARE:			5 Gauzed wrapped	8 Saw cut	11 None (open hole)
1 Continuous slot	3 Mill slot	6 Wire wrapped	9 Drilled holes		
2 Louvered shutter	4 Key punched	7 Torch cut	10 Other (specify)		
SCREEN-PERFORATED INTERVALS:		From ft. to ft., From ft. to ft.			
		From ft. to ft., From ft. to ft.			
GRAVEL PACK INTERVALS:		From ft. to ft., From ft. to ft.			
		From ft. to ft., From ft. to ft.			

6 GROUT MATERIAL:		1 Neat cement	2 Cement grout	3 Bentonite	4 Other
Grout Intervals:		From..... ft. to	ft., From..... ft. to	ft., From..... ft. to	ft.
What is the nearest source of possible contamination:				10 Livestock pens	14 Abandoned water well
1 Septic tank	4 Lateral lines	7 Pit privy	11 Fuel storage	15 Oil well/Gas well	
2 Sewer lines	5 Cess pool	8 Sewage lagoon	12 Fertilizer storage	16 Other (specify below)	
3 Watertight sewer lines	6 Seepage pit	9 Feedyard	13 Insecticide storage		
Direction from well?			How many feet?		

[illegible]

7. CONTRACTOR'S OR LANDOWNER'S CERTIFICATION: This water well was (1) constructed, (2) reconstructed, or (3) plugged under my jurisdiction and was completed on (mo/day/year) 6/11/96 and this record is true to the best of my knowledge and belief. Kansas Water Well Contractor's License No. This Water Well Record was completed on (mo/day/yr) 6/11/96 under the business name of White & Ellis Drilling, Inc. by (signature) Judith A. Strichen

INSTRUCTIONS: Use typewriter or ball point pen. **PLEASE PRESS FIRMLY** and **PRINT** clearly. Please fill in blanks, underline or circle the correct answers. Send top three copies to Kansas Department of Health and Environment, Bureau of Water, Topeka, Kansas 66620-0001. Telephone: 913-296-5545. Send one to **WATER WELL OWNER** and retain one for your records.