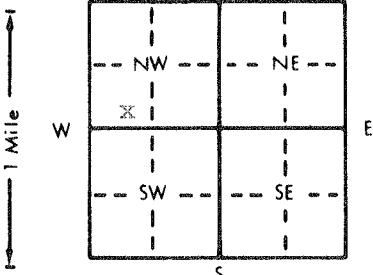


1 LOCATION OF WATER WELL:	Fraction	Section Number	Township Number	Range Number
County: Thomas	SE 1/4 SW 1/4 NW 1/4	17	T 9 S	R 31 E/W

Distance and direction from nearest town or city street address of well if located within city?

9 1/2 north 3 east of Oakley Kansas

2 WATER WELL OWNER: Juston Sowers	Board of Agriculture, Division of Water Resources
RR#, St. Address, Box # : 154 Main	Application Number:
City, State, ZIP Code : Bird City, Kansas 67731	

3 LOCATE WELL'S LOCATION WITH AN "X" IN SECTION BOX:	4 DEPTH OF COMPLETED WELL: 125 ft. ELEVATION:
	Depth(s) Groundwater Encountered 1. ft. 2. ft. 3. ft.
	WELL'S STATIC WATER LEVEL: 77 ft. below land surface measured on mo/day/yr 9-24-97
	Pump test data: Well water was ft. after hours pumping gpm
	Est. Yield gpm: Well water was not tested ft. after hours pumping gpm
	Bore Hole Diameter: 8 in. to 125 ft., and in. to ft.
	WELL WATER TO BE USED AS:
	5 Public water supply 8 Air conditioning 11 Injection well
	1 Domestic 3 Feedlot 6 Oil field water supply 9 Dewatering 12 Other (Specify below)
	2 Irrigation 4 Industrial 7 Lawn and garden only 10 Monitoring well
	Was a chemical/bacteriological sample submitted to Department? Yes No X; If yes, mo/day/yr sample was submitted
	Water Well Disinfected? Yes X No

5 TYPE OF BLANK CASING USED:	5 Wrought iron	8 Concrete tile	CASING JOINTS: Glued X Clamped
1 Steel	3 RMP (SR)	6 Asbestos-Cement	9 Other (specify below)
2 PVC	4 ABS	7 Fiberglass	10 Asbestos-cement
Blank casing diameter 5 in. to 105 ft., Dia			11 Other (specify)
Casing height above land surface 18 in., weight 2.6 lbs./ft.			12 None used (open hole)
TYPE OF SCREEN OR PERFORATION MATERIAL:	7 PVC		
1 Steel	3 Stainless steel	5 Fiberglass	8 RMP (SR)
2 Brass	4 Galvanized steel	6 Concrete tile	9 ABS
SCREEN OR PERFORATION OPENINGS ARE:	5 Gauzed wrapped	8 Saw cut	11 None (open hole)
1 Continuous slot	3 Mill slot	6 Wire wrapped	9 Drilled holes
2 Louvered shutter	4 Key punched	7 Torch cut	10 Other (specify)
SCREEN-PERFORATED INTERVALS:	From 105 ft. to 125 ft.		
	From ft. to ft.		
GRAVEL PACK INTERVALS:	From 18 ft. to 125 ft.		
	From ft. to ft.		

6 GROUT MATERIAL:	1 Neat cement	2 Cement grout	3 Bentonite	4 Other
Grout Intervals:	From 4 ft. to 18 ft.			
What is the nearest source of possible contamination:				
1 Septic tank	4 Lateral lines	7 Pit privy	10 Livestock pens	14 Abandoned water well
2 Sewer lines	5 Cess pool	8 Sewage lagoon	11 Fuel storage	15 Oil well/Gas well
3 Watertight sewer lines	6 Seepage pit	9 Feedyard	12 Fertilizer storage	16 Other (specify below)
			13 Insecticide storage	in pasture
Direction from well?			How many feet?	

FROM	TO	LITHOLOGIC LOG	FROM	TO	PLUGGING INTERVALS
0	14	top soil			
14	19	sand			
19	33	clay			
33	38	sandy clay			
38	46	sand and sand rock strips			
46	60	sand			
60	85	sand and sand rock strips			
85	91	sand rock hard			
91	122	sand and sand rock			
122	125	oker and shale			

7 CONTRACTOR'S OR LANDOWNER'S CERTIFICATION: This water well was (1) constructed, (2) reconstructed, or (3) plugged under my jurisdiction and was completed on (mo/day/year) 9-24-97 and this record is true to the best of my knowledge and belief, Kansas Water Well Contractor's License No. 139 This Water Well Record was completed on (mo/day/yr) 6-19-98 under the business name of Bartell Drilling by (signature) [Signature]
--