

1 LOCATION OF WATER WELL: County: <u>Thomas</u>	Fraction <u>SE</u> $\frac{1}{4}$ <u>NE</u> $\frac{1}{4}$ <u>SE</u> $\frac{1}{4}$	Section Number <u>19</u>	Township Number <u>T 9</u> <u>S</u>	Range Number <u>R 31</u> <u>E(W)</u>
--	---	-----------------------------	--	---

Distance and direction from nearest town or city street address of well if located within city?

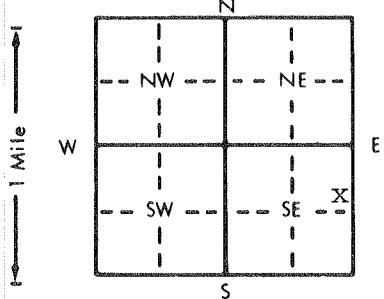
8 1/2 N 3E of Oakley2 WATER WELL OWNER: Herbert MaierRR#, St. Address, Box # : Rt 1

Board of Agriculture, Division of Water Resources

City, State, ZIP Code : Oakley, Ks 67748

Application Number:

3 LOCATE WELL'S LOCATION WITH AN "X" IN SECTION BOX:

4 DEPTH OF COMPLETED WELL: 187 ft. ELEVATION:Depth(s) Groundwater Encountered 1. 187 ft. 2. 9.0 ft. 3. 9.0 ft.WELL'S STATIC WATER LEVEL 9.0 ft. below land surface measured on mo/day/yr 6-22-90Pump test data: Well water was not tested after hours pumping gpmEst. Yield gpm: Well water was ft. after hours pumping gpmBore Hole Diameter 8 in. to 18.7 ft., and in. to ft.

WELL WATER TO BE USED AS: 5 Public water supply 8 Air conditioning 11 Injection well

1 Domestic 3 Feedlot 6 Oil field water supply 9 Dewatering 12 Other (Specify below)

2 Irrigation 4 Industrial 7 Lawn and garden only 10 Monitoring well

Was a chemical/bacteriological sample submitted to Department? Yes No X; If yes, mo/day/yr sample was submittedWater Well Disinfected? Yes X No

5 TYPE OF BLANK CASING USED:

1 Steel 3 RMP (SR)

2 PVC 4 ABS

5 Wrought iron

6 Asbestos-Cement

7 Fiberglass

8 Concrete tile

9 Other (specify below)

CASING JOINTS: Glued X Clamped

Welded

Threaded

Blank casing diameter 5 in. to 16.7 ft., Dia in. to ft., Dia in. to ft.Casing height above land surface 18 in., weight 1.8/10 lbs./ft. Wall thickness or gauge No. 1/4"

TYPE OF SCREEN OR PERFORATION MATERIAL:

1 Steel 3 Stainless steel

2 Brass 4 Galvanized steel

5 Fiberglass

6 Concrete tile

7 PVC

8 RMP (SR)

9 ABS

10 Asbestos-cement

11 Other (specify)

12 None used (open hole)

SCREEN OR PERFORATION OPENINGS ARE:

1 Continuous slot 3 Mill slot

2 Louvered shutter 4 Key punched

5 Gauzed wrapped

6 Wire wrapped

7 Torch cut

8 Saw cut

9 Drilled holes

10 Other (specify)

11 None (open hole)

SCREEN-PERFORATED INTERVALS: From 16.7 ft. to 187 ft., From ft. to ft., From ft. to ft.From ft. to ft., From ft. to ft., From ft. to ft.GRAVEL PACK INTERVALS: From 18 ft. to 187 ft., From ft. to ft., From ft. to ft.From ft. to ft., From ft. to ft., From ft. to ft.

6 GROUT MATERIAL:

1 Neat cement

2 Cement grout

3 Bentonite

4 Other

Grout Intervals: From 4 ft. to 18 ft., From ft. to ft., From ft. to ft.

What is the nearest source of possible contamination:

1 Septic tank 4 Lateral lines

2 Sewer lines 5 Cess pool

3 Watertight sewer lines 6 Seepage pit

7 Pit privy

8 Sewage lagoon

9 Feedyard

10 Livestock pens

11 Fuel storage

12 Fertilizer storage

13 Insecticide storage

14 Abandoned water well

15 Oil well/Gas well

16 Other (specify below)

Direction from well?

southHow many feet? 300

FROM	TO	LITHOLOGIC LOG	FROM	TO	PLUGGING INTERVALS
0	40	top soil			
40	55	sandy clay			
55	65	sand and clay strips			
65	97	sand and sand rock strips			
97	101	sand			
101	105	sand rock			
105	117	sand			
117	130	sandy clay			
130	152	sand			
152	161	sand rock hard			
161	183	sand good			
183	187	oker and shale			

7 CONTRACTOR'S OR LANDOWNER'S CERTIFICATION: This water well was (1) constructed, (2) reconstructed, or (3) plugged under my jurisdiction and was completed on (mo/day/year) 6-22-90 and this record is true to the best of my knowledge and belief. KansasWater Well Contractor's License No. 139This Water Well Record was completed on (mo/day/yr) 6-23-90

under the business name of

Bartell Drilling

by (signature)

INSTRUCTIONS: Use typewriter or ball point pen. PLEASE PRESS FIRMLY and PRINT clearly. Please fill in blanks, underline or circle the correct answers. Send top three copies to Kansas Department of Health and Environment, Bureau of Water Protection, Topeka, Kansas 66620-7320. Telephone: 913-296-5514. Send one to WATER WELL OWNER and retain one for your records.