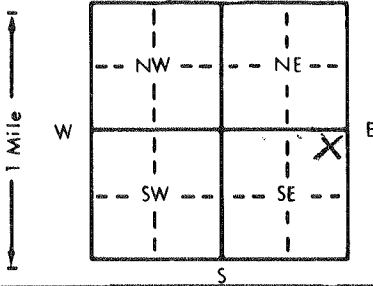


1 LOCATION OF WATER WELL:		Fraction	Section Number	Township Number	Range Number
County: <u>Thomas</u>		<u>NE 1/4 NE 1/4 SE 1/4</u>	<u>13</u>	<u>T 9 S</u>	<u>R 31 E W</u>
Distance and direction from nearest town or city street address of well if located within city? <u>6 Miles South of Menlo</u>					
2 WATER WELL OWNER: <u>Gary Davis</u>					
RR#, St. Address, Box # : <u>Menlo, Ks. 67753</u>					
City, State, ZIP Code : _____ Board of Agriculture, Division of Water Resources					
Application Number: _____					
3 LOCATE WELL'S LOCATION WITH AN "X" IN SECTION BOX:		4 DEPTH OF COMPLETED WELL: <u>154</u> ft. ELEVATION: _____			
		Depth(s) Groundwater Encountered 1. _____ ft. 2. _____ ft. 3. _____ ft.			
		WELL'S STATIC WATER LEVEL: <u>8.6</u> ft. below land surface measured on mo/day/yr _____			
		Pump test data: Well water was _____ ft. after _____ hours pumping _____ gpm			
		Est. Yield _____ gpm: Well water was _____ ft. after _____ hours pumping _____ gpm			
		Bore Hole Diameter: <u>8</u> in. to <u>154</u> ft., and _____ in. to _____ ft.			
WELL WATER TO BE USED AS:		5 Public water supply 8 Air conditioning 11 Injection well			
1 Domestic 3 Feedlot 6 Oil field water supply 9 Dewatering 12 Other (Specify below)					
2 Irrigation 4 Industrial 7 Lawn and garden only 10 Monitoring well					
Was a chemical/bacteriological sample submitted to Department? Yes _____ No <u>X</u> _____; If yes, mo/day/yr sample was submitted _____					
Water Well Disinfected? Yes _____ No <u>X</u> _____					
5 TYPE OF BLANK CASING USED:					
1 Steel 3 RMP (SR)		5 Wrought iron 8 Concrete tile		CASING JOINTS: Glued <u>X</u> Clamped _____	
2 PVC 4 ABS		6 Asbestos-Cement 9 Other (specify below)		Welded _____	
Blank casing diameter: <u>4.5</u> in. to <u>134</u> ft., Dia _____ in. to _____ ft., Dia _____ in. to _____ ft.		7 Fiberglass		Threaded _____	
Casing height above land surface: <u>18</u> in., weight <u>2.38</u> lbs./ft. Wall thickness or gauge No. <u>248</u>					
TYPE OF SCREEN OR PERFORATION MATERIAL:					
1 Steel 3 Stainless steel 5 Fiberglass 7 PVC 10 Asbestos-cement					
2 Brass 4 Galvanized steel 6 Concrete tile 8 RMP (SR) 11 Other (specify) _____					
SCREEN OR PERFORATION OPENINGS ARE:		5 Gauzed wrapped 8 Saw cut 11 None (open hole)			
1 Continuous slot 3 Mill slot 6 Wire wrapped 9 Drilled holes					
2 Louvered shutter 4 Key punched 7 Torch cut 10 Other (specify) _____					
SCREEN-PERFORATED INTERVALS: From _____ ft. to _____ ft., From _____ ft. to _____ ft., From _____ ft. to _____ ft.					
GRAVEL PACK INTERVALS: From <u>20</u> ft. to <u>154</u> ft., From _____ ft. to _____ ft., From _____ ft. to _____ ft.					
6 GROUT MATERIAL: 1 Neat cement 2 Cement grout 3 Bentonite 4 Other _____					
Grout Intervals: From <u>0</u> ft. to <u>20</u> ft., From _____ ft. to _____ ft., From _____ ft. to _____ ft.					
What is the nearest source of possible contamination:					
1 Septic tank 4 Lateral lines 7 Pit privy 10 Livestock pens 14 Abandoned water well					
2 Sewer lines 5 Cess pool 8 Sewage lagoon 11 Fuel storage 15 Oil well/Gas well					
3 Watertight sewer lines 6 Seepage pit 9 Feedyard 12 Fertilizer storage 16 Other (specify below)					
13 Insecticide storage					
Direction from well? <u>Southeast</u>		How many feet? <u>300'</u>			
FROM	TO	LITHOLOGIC LOG	FROM	TO	PLUGGING INTERVALS
0	2	Surface	129	131	Sticky Clay
2	11	Loess	131	149	Med. Sand & Gravel w/a few Clay Strks.
11	15	Fine Sand			
15	25	Fine to Med. Sand w/Clay Strk	149	154	Ochra
25	47	Med. Sand & Gravel w/Clay St.			
47	56	Sandy Clay w/a few Sand Strks.			
56	60	Fine Sand w/Clay Strks.			
60	76	Sticky Clay w/Caliche Strks.			
76	80	Med. Sand w/Clay Strks.&Gravel			
80	89	Med. Sand & Gravel w/a few Fine Clay Strks.			
89	91	Sandy Clay & Caliche			
91	117	Med. Sand & Gravel w/a few Clay Strks.			
117	122	Sandy Clay Caliche & Med. Sand Mix			
122	129	Cemented Sand w/Sand Strks.			
7 CONTRACTOR'S OR LANDOWNER'S CERTIFICATION: This water well was (1) constructed, (2) reconstructed, or (3) plugged under my jurisdiction and was completed on (mo/day/year) <u>4-15-95</u> and this record is true to the best of my knowledge and belief. Kansas Water Well Contractor's License No. <u>554</u> This Water Well Record was completed on (mo/day/yr) <u>4-17-95</u> under the business name of <u>Woofter Pump & Well, Inc.</u> by (signature) <u>Gary C. Woofter</u>					