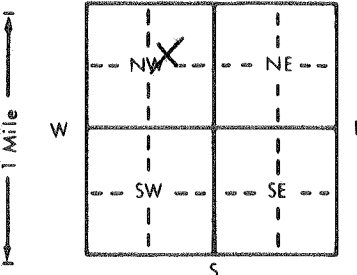


1 LOCATION OF WATER WELL: County: <u>Thomas</u>	Fraction SW $\frac{1}{4}$ NE $\frac{1}{4}$ NW $\frac{1}{4}$	Section Number <u>22</u>	Township Number T <u>9</u> S	Range Number R <u>32</u> <u>EW</u>
--	--	-----------------------------	---------------------------------	---------------------------------------

Distance and direction from nearest town or city street address of well if located within city?

2 WATER WELL OWNER: RR#, St. Address, Box # : <u>Robert Renner</u> City, State, ZIP Code : <u>2744 County Road J</u> <u>Oakley, KS 67748</u>	<u>Abercrombie RTD</u> <u>150 Main Suite 801</u> <u>Wichita, KS 67202-1383</u>	Board of Agriculture, Division of Water Resources Application Number: <u>970058</u>
---	--	--

3 LOCATE WELL'S LOCATION WITH AN "X" IN SECTION BOX: 	4 DEPTH OF COMPLETED WELL: <u>190</u> ft. ELEVATION: <u>133</u> ft. Depth(s) Groundwater Encountered <u>1</u> ft. 2. ft. 3. ft. WELL'S STATIC WATER LEVEL <u>133</u> ft. below land surface measured on mo/day/yr Pump test data: Well water was ft. after hours pumping gpm Est. Yield gpm: Well water was ft. after hours pumping gpm Bore Hole Diameter in. to ft. and in. to ft. WELL WATER TO BE USED AS: <input checked="" type="checkbox"/> Domestic <input type="checkbox"/> 3 Feedlot <input checked="" type="checkbox"/> 6 Oil field water supply <input type="checkbox"/> 9 Dewatering <input type="checkbox"/> 12 Other (Specify below) <input type="checkbox"/> 2 Irrigation <input type="checkbox"/> 4 Industrial <input checked="" type="checkbox"/> 7 Lawn and garden only <input type="checkbox"/> 10 Monitoring well Was a chemical/bacteriological sample submitted to Department? Yes.....No.....; If yes, mo/day/yr sample was submitted Water Well Disinfected? Yes No
--	--

5 TYPE OF BLANK CASING USED: 1 Steel 2 PVC Blank casing diameter in. to ft., Dia in. to ft., Dia in. to ft. Casing height above land surface - <u>36</u> in., weight lbs./ft. Wall thickness or gauge No. TYPE OF SCREEN OR PERFORATION MATERIAL: 1 Steel 2 Brass SCREEN OR PERFORATION OPENINGS ARE: 1 Continuous slot 2 Louvered shutter SCREEN-PERFORATED INTERVALS: From ft. to ft., From ft. to ft., From ft. to ft. GRAVEL PACK INTERVALS: From ft. to ft., From ft. to ft., From ft. to ft.	5 Wrought iron 6 Asbestos-Cement 7 Fiberglass 8 Concrete tile 9 Other (specify below) CASING JOINTS: Glued Clamped Welded Threaded 10 Asbestos-cement 11 Other (specify) 12 None used (open hole) 8 Saw cut 9 Drilled holes 10 Other (specify) 11 None (open hole) 5 Gauzed wrapped 6 Wire wrapped 7 Torch cut
---	---

6 GROUT MATERIAL: 1 Neat cement 2 Cement grout 3 Bentonite 4 Other Grout Intervals: From <u>6</u> ft. to <u>3</u> ft., From ft. to ft., From ft. to ft. What is the nearest source of possible contamination: 1 Septic tank 2 Sewer lines 3 Watertight sewer lines 4 Lateral lines 5 Cess pool 6 Seepage pit 7 Pit privy 8 Sewage lagoon 9 Feedyard 10 Livestock pens 11 Fuel storage 12 Fertilizer storage 13 Insecticide storage 14 Abandoned water well 15 Oil well/Gas well 16 Other (specify below)
--

Direction from well?		How many feet?	
FROM	TO	FROM	TO
		190	133
		133	6
		6	3
		3	0
LITHOLOGIC LOG		PLUGGING INTERVALS	
		Washed Sand	
		Clay	
		Bentonite	
		Topsoil	

7 CONTRACTOR'S OR LANDOWNER'S CERTIFICATION: This water well was (1) constructed, (2) reconstructed, or (3) plugged under my jurisdiction and was completed on (mo/day/year) <u>3-10-97</u> and this record is true to the best of my knowledge and belief. Kansas Water Well Contractor's License No. <u>554</u> This Water Well Record was completed on (mo/day/yr) <u>3-14-97</u> under the business name of <u>Woofter Pump & Well, Inc.</u> by (signature) <u>Gay C. Woofter</u>
