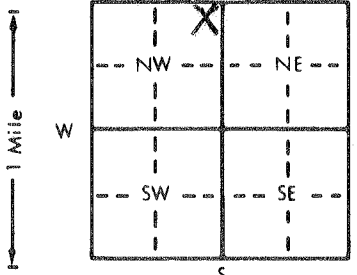


1 LOCATION OF WATER WELL:	Fraction	Section Number	Township Number	Range Number
County: Thomas	NE 1/4 NE 1/4 NW 1/4	21	T 9 S	R 32

Distance and direction from nearest town or city street address of well if located within city?

5 miles north, 1 mile west of Oakley

2 WATER WELL OWNER:	Robert Renner	Abercrombie Drilling
RR#, St. Address, Box # :	Rt. 2	801 Union
City, State, ZIP Code :	Oakley, Ks. 67748	Wichita, Ks. 67202
		Board of Agriculture, Division of Water Resources
		Application Number: 930163

3 LOCATE WELL'S LOCATION WITH AN "X" IN SECTION BOX:	4 DEPTH OF COMPLETED WELL: 186 ft. ELEVATION:
	Depth(s) Groundwater Encountered 1. ft. 2. ft. 3. ft.
	WELL'S STATIC WATER LEVEL 121 ft. below land surface measured on mo/day/yr
	Pump test data: Well water was ft. after hours pumping gpm
	Est. Yield gpm: Well water was ft. after hours pumping gpm
	Bore Hole Diameter 8 in. to 186 ft. and in. to ft.
	WELL WATER TO BE USED AS:
	5 Public water supply 8 Air conditioning 11 Injection well
	1 Domestic 3 Feedlot 6 Oil field water supply 9 Dewatering 12 Other (Specify below)
	2 Irrigation 4 Industrial 7 Lawn and garden only 10 Monitoring well
	Was a chemical/bacteriological sample submitted to Department? Yes.....No.....X; If yes, mo/day/yr sample was submitted
	Water Well Disinfected? Yes No X

5 TYPE OF BLANK CASING USED:	5 Wrought iron	8 Concrete tile	CASING JOINTS: Glued X Clamped
1 Steel	3 RMP (SR)	6 Asbestos-Cement	9 Other (specify below)
2 PVC	4 ABS	7 Fiberglass	10 Asbestos-cement
Blank casing diameter 4.5 in. to 146 ft. Dia			
Casing height above land surface 18 in. weight 2.38 lbs./ft. Wall thickness or gauge No. 248			
TYPE OF SCREEN OR PERFORATION MATERIAL:	7 PVC	10 Asbestos-cement	
1 Steel	3 Stainless steel	5 Fiberglass	8 RMP (SR)
2 Brass	4 Galvanized steel	6 Concrete tile	9 ABS
SCREEN OR PERFORATION OPENINGS ARE:	5 Gauzed wrapped	8 Saw cut	11 None (open hole)
1 Continuous slot	3 Mill slot	6 Wire wrapped	9 Drilled holes
2 Louvered shutter	4 Key punched	7 Torch cut	10 Other (specify)
SCREEN-PERFORATED INTERVALS:	From 146 ft. to 186 ft.		
	From 20 ft. to 186 ft.		
GRAVEL PACK INTERVALS:	From 20 ft. to 186 ft.		

6 GROUT MATERIAL:	1 Neat cement	2 Cement grout	3 Bentonite	4 Other
Grout Intervals:	From 0 ft. to 20 ft.			
What is the nearest source of possible contamination:				
1 Septic tank	4 Lateral lines	7 Pit privy	10 Livestock pens	14 Abandoned water well
2 Sewer lines	5 Cess pool	8 Sewage lagoon	11 Fuel storage	15 Oil well/Gas well
3 Watertight sewer lines	6 Seepage pit	9 Feedyard	12 Fertilizer storage	16 Other (specify below)
Direction from well? North			13 Insecticide storage	
			How many feet? 150'	

FROM	TO	LITHOLOGIC LOG	FROM	TO	PLUGGING INTERVALS
0	3	Surface	90	109	Sandy Clay w/Cement sand & Caliche Strks.
3	25	Clay w/caliche strks.			
25	26	Fine to Med. Sand	109	120	Clay
26	34	Clay w/sand & caliche strks.	120	138	Med to coarse sand
34	39	Fine to med. Sand w/clay strks	138	149	Med. Sand
39	41	Caliche	149	162	Clay
41	56	Large Sand & Gravel	162	163	Caliche
56	61	Clay w/caliche strks.	163	167	Fine Sand
61	64	Cemented sand w/caliche strks.	167	169	Caliche
64	66	Clay	169	174	Fine Sand
66	74	Med. to Large sand	174	177	Fine to Med. Sand w/caliche
74	77	Cemented Sand	177	179	Clay w/caliche & sand strks.
77	79	Fine to Med. Sand	179	186	Med. Coarse Sand
79	84	Cemented Sand, Caliche & Clay strks			
84	90	Clay	186		Shale

7 CONTRACTOR'S OR LANDOWNER'S CERTIFICATION: This water well was (1) constructed, (2) reconstructed, or (3) plugged under my jurisdiction and was completed on (mo/day/year) 5-21-93 and this record is true to the best of my knowledge and belief. Kansas
Water Well Contractor's License No. 554 This Water Well Record was completed on (mo/day/yr) 5-24-93
under the business name of WOOFER PUMP & Well, Inc. by (signature) Jay C. Woffter