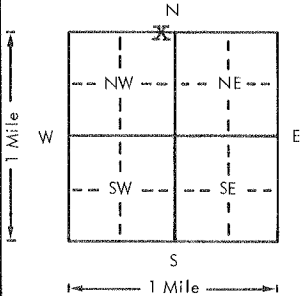


USE TYPEWRITER OR BALL  
POINT PEN-PRESS FIRMLY,  
PRINT CLEARLY.

WATER WELL RECORD  
KSA 82a-1201-1215

Kansas Department of Health and  
Environment-Division of Environment  
(Water well Contractors)  
Topeka, Kansas 66620

1. Location of well:		County <b>Thomas</b>	Fraction <b>NE 1/4 NE 1/4 NW 1/4</b>	Section number <b>21</b>	Township number <b>T 9 S R</b>	Range number <b>32E/W</b>
2. Distance and direction from nearest town or city: <b>11 1/2 N.W. of Oakley</b> Street address of well location if in city:				3. Owner of well: <b>John A. Renner</b> R.R. or street: <b>Box 132 R.R. 2</b> City, state, zip code: <b>Oakley, Kansas 67764</b>		
4. Locate with "X" in section below:		Sketch map:		6. Bore hole dia. <b>8</b> in. Completion date <b>9/6/77</b> Well depth <b>198</b> ft.		
				7. <input checked="" type="checkbox"/> Cable tool <input checked="" type="checkbox"/> Rotary <input type="checkbox"/> Driven <input type="checkbox"/> Dug <input type="checkbox"/> Hollow rod <input type="checkbox"/> Jetted <input type="checkbox"/> Bored <input type="checkbox"/> Reverse rotary		
				8. Use: <input checked="" type="checkbox"/> Domestic <input type="checkbox"/> Public supply <input type="checkbox"/> Industry <input type="checkbox"/> Irrigation <input type="checkbox"/> Air conditioning <input type="checkbox"/> Stock <input type="checkbox"/> Lawn <input type="checkbox"/> Oil field water <input type="checkbox"/> Other		
5. Type and color of material		From		To		9. Casing: Material <b>plst</b> Weight: Above or below Threaded <input type="checkbox"/> Welded <input type="checkbox"/> Surface <b>15</b> in. RMP <input checked="" type="checkbox"/> PVC <input type="checkbox"/> Weight <input type="checkbox"/> lbs./ft. Dia. <b>5</b> in. to <b>198</b> depth Wall Thickness: inches or Dia. <input type="checkbox"/> in. to <input type="checkbox"/> ft. depth gage No. <b>250</b>
Top Soil		0		37		10. Screen: Manufacturer's name <b>J/L</b> <b>3&amp;L</b> Type <b>RMP</b> Dia. <b>5"</b> Slot/gauze <b>.032</b> Length <b>20'</b> Set between <b>178</b> ft. and <b>198</b> ft. ft. and <input type="checkbox"/> ft. Gravel pack? <input checked="" type="checkbox"/> yes Range of material <b>1/8"</b>
Sand		37		51		11. Static water level: <input type="checkbox"/> mo./day/yr. <b>104</b> ft. below land surface Date <input type="checkbox"/>
Sand Rock		51		55		12. Pumping level below land surfaces: ft. after <b>N.A.</b> hrs. pumping <input type="checkbox"/> g.p.m. ft. after <input type="checkbox"/> hrs. pumping <input type="checkbox"/> g.p.m. Estimated maximum yield <input type="checkbox"/> g.p.m.
Sand Clay Sand Strips		55		70		13. Water sample submitted: <input type="checkbox"/> mo./day/yr. Yes <input checked="" type="checkbox"/> No Date <input type="checkbox"/>
Sand and Sand Rock Strips		70		89		14. Well head completion: <input checked="" type="checkbox"/> Pitless adapter <b>20</b> Inches above grade
Sand Clay		89		97		15. Well grouted? <b>yes</b> With: <input checked="" type="checkbox"/> Neat cement <input type="checkbox"/> Bentonite <input type="checkbox"/> Concrete Depth: From <b>4</b> ft. to <b>18</b> ft.
Sand and Sand Rock Strips		97		131		16. Nearest source of possible contamination: ft. <input type="checkbox"/> Direction <b>N.A.</b> Type <input type="checkbox"/> Well disinfected upon completion? <input checked="" type="checkbox"/> Yes <input type="checkbox"/> No
Sand Rock and Sand Strips		131		163		17. Pump: <input checked="" type="checkbox"/> Not installed Manufacturer's name <input type="checkbox"/> Model number <input type="checkbox"/> HP <input type="checkbox"/> Volts <input type="checkbox"/> Length of drop pipe <input type="checkbox"/> ft. capacity <input type="checkbox"/> g.p.m. Type: <input type="checkbox"/> Submersible <input type="checkbox"/> Turbine <input type="checkbox"/> Jet <input type="checkbox"/> Reciprocating <input type="checkbox"/> Centrifugal <input type="checkbox"/> Other
Sand Clay		163		166		20. Water well contractor's certification: This well was drilled under my jurisdiction and this report is true to the best of my knowledge and belief. <b>Bartell Drilling</b> <b>13</b> Business name License No. Address <b>Winona, Kansas 67764</b> Signed <b>Joyce Bartell</b> Date <b>7/7/79</b> Authorized representative
Sand Rock and Sand Strips		166		170		
Sand Rock Hard		170		184		
Sand Good		184		195		
Uker		195		197		
Shale		197		198		
BROCK 195'						
(Use a second sheet if needed)						
18. Elevation:		19. Remarks:				
Topography: <input type="checkbox"/> Hill <input checked="" type="checkbox"/> Slope <input type="checkbox"/> Upland <input type="checkbox"/> Valley						

Forward the white, blue and pink copies to the Department of Health and Environment

Form WWC-5