

USE TYPEWRITER OR BALL
POINT PEN. PRESS FIRMLY,
PRINT CLEARLY.

WATER WELL RECORD
KSA 82a-1201-1215

Kansas Department of Health and
Environment-Division of Environment
(Water well Contractors)
Topeka, Kansas 66620

Well #2 Job #46-77-B-23-9-32 **BDC** (REVISED)

1. Location of well:	County Thomas	Fraction SW 1/4 SE 1/4 NW 1/4	Section number 23	Township number T 9 S	Range number R 32 W
2. Distance and direction from nearest town or city: 1 South; 2 East; 1/2 South; 1/4 East Street address of well location if in city:			3. Owner of well: John Renner R.R. or street: City, state, zip code: Mingo, KS		
4. Locate with "X" in section below: <div style="text-align: center;">N 1 Mile W 1 Mile S E</div> Sketch map:			6. Bore hole dia. 30 in. Completion date 3-1-77 Well depth 203 ft.		
5. Type and color of material			7. <input type="checkbox"/> Cable tool <input type="checkbox"/> Rotary <input type="checkbox"/> Driven <input type="checkbox"/> Dug <input type="checkbox"/> Hollow rod <input type="checkbox"/> Jetted <input checked="" type="checkbox"/> Bored <input checked="" type="checkbox"/> Reverse rotary		
			8. Use: <input type="checkbox"/> Domestic <input type="checkbox"/> Public supply <input type="checkbox"/> Industry <input checked="" type="checkbox"/> Irrigation <input type="checkbox"/> Air conditioning <input type="checkbox"/> Stock <input type="checkbox"/> Lawn <input type="checkbox"/> Oil field water <input type="checkbox"/> Other		
			9. Casing: Material Steel Height: Above or below xxxxx Threaded <input type="checkbox"/> Welded <input checked="" type="checkbox"/> Surface 12 in. RMP <input type="checkbox"/> PVC <input type="checkbox"/> Weight .188 lbs./ft. Dia. 16 in. to 113 ft. depth Wall Thickness: inches or Dia. <input type="checkbox"/> in. to <input type="checkbox"/> ft. depth Gauge No. #7		
			10. Screen: Manufacturer's name Brown Type Regular Dia. 16" Slot/gauze 10% Length 80" Set between 113 ft. and 193 ft. 10' Cook 193 ft. and 203 ft. Gravel pack? <input checked="" type="checkbox"/> Size range of material 30% #1 70% #5/16		
			11. Static water level: 104 ft. below land surface Date 3-3-77 mo./day/yr.		
(Use a second sheet if needed)			12. Pumping level below land surfaces: 147 ft. after 2 hrs. pumping 1130 g.p.m. ____ ft. after ____ hrs. pumping ____ g.p.m. Estimated maximum yield 1130 g.p.m.		
			13. Water sample submitted: ____ mo./day/yr. Yes <input checked="" type="checkbox"/> No <input type="checkbox"/> Date ____		
			14. Well head completion: <input type="checkbox"/> Pitless adapter 12 inches above grade		
			15. Well grouted? <input checked="" type="checkbox"/> With: <input type="checkbox"/> Neat cement <input checked="" type="checkbox"/> Bentonite <input checked="" type="checkbox"/> Clay Depth: From 0 ft. to 10 ft.		
			16. Nearest source of possible contamination: ft. 1 mile Direction S Type Farmhouse Well disinfected upon completion? Yes <input checked="" type="checkbox"/> No <input type="checkbox"/>		
			17. Pump: <input checked="" type="checkbox"/> Not installed Manufacturer's name ____ Model number ____ HP ____ Volts ____ Length of drop pipe ____ ft. capacity ____ g.p.m. Type: <input type="checkbox"/> Submersible <input type="checkbox"/> Turbine <input type="checkbox"/> Jet <input type="checkbox"/> Reciprocating <input type="checkbox"/> Centrifugal <input type="checkbox"/> Other		
			20. Water well contractor's certification: This well was drilled under my jurisdiction and this report is true to the best of my knowledge and belief. Western Well & Pump 245 Business name License No. Address Box 852 Colby, KS 67701 Signed Sally Perry Date 3/18/77 Authorized representative		
			18. Elevation:		
			19. Remarks: 3066 (TOPO)		
			Topography: <input type="checkbox"/> Hill <input type="checkbox"/> Slope <input checked="" type="checkbox"/> Upland <input type="checkbox"/> Valley		

Forward the white, blue and pink copies to the Department of Health and Environment

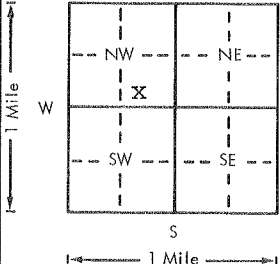
Form WWC-5

USE TYPEWRITER OR BALL
POINT PEN-PRESS FIRMLY,
PRINT CLEARLY.

WATER WELL RECORD
KSA 82a-1201-1215

Kansas Department of Health and
Environment-Division of Environment
(Water well Contractors)
Topeka, Kansas 66620

Well #2

1. Location of well:	County Thomas	Section SW SE NW 1/4 NE 1/4 NW 1/4	Section number 23	Township number T 9 S	Range number R 32 E
2. Distance and direction from nearest town or city: 1 South; 2 East; 1/2 South; 1/4 East Street address of well location if in city:		3. Owner of well: John Renner R.R. or street: City, state, zip code: Mingo, KS			
4. Locate with "X" in section below: N 1 Mile W E S 1 Mile		Sketch map: 		6. Bore hole dia. 30 in. Completion date 3-1-77 Well depth 203 ft.	
5. Type and color of material		From	To	7. <input type="checkbox"/> Cable tool <input type="checkbox"/> Rotary <input type="checkbox"/> Driven <input type="checkbox"/> Dug <input type="checkbox"/> Hollow rod <input type="checkbox"/> Jetted <input checked="" type="checkbox"/> Bored <input checked="" type="checkbox"/> Reverse rotary	
Clay, Coarse Sand		0	120	8. Use: <input type="checkbox"/> Domestic <input type="checkbox"/> Public supply <input type="checkbox"/> Industry <input checked="" type="checkbox"/> Irrigation <input type="checkbox"/> Air conditioning <input type="checkbox"/> Stock <input type="checkbox"/> Lawn <input type="checkbox"/> Oil field water <input type="checkbox"/> Other	
Coarse Sand, Clay Streaks, Sandstone		120	180	9. Casing: Material Steel Height: Above or below Threaded <input type="checkbox"/> Welded <input checked="" type="checkbox"/> Surface xxxx RMP <input type="checkbox"/> PVC <input type="checkbox"/> Weight 12 in. Dia. 16 in. to 113 ft. depth Wall Thickness: inches or Dia. 10 in. to 193 ft. depth gauge No. #7	
Coa. Sand, Med. Gravel, Clay Streaks, Sandstone		180	200	10. Screen: Manufacturer's name Brown Type Regular Dia. 16" Slot/gauze 10% Length 80' Set between 113 ft. and 193 ft. 10' Cook 193 ft. and 203 ft.	
Ochre, Shale		200	203	Gravel pack? <input checked="" type="checkbox"/> Size range of material 30% 1/4x5/	
				11. Static water level: 104 ft. below land surface Date 3-3-77 mo./day/yr.	
				12. Pumping level below land surfaces: 147 ft. after 2 hrs. pumping 654 g.p.m. ft. after hrs. pumping g.p.m. Estimated maximum yield 654 g.p.m.	
				13. Water sample submitted: X Yes <input type="checkbox"/> No Date	
				14. Well head completion: <input type="checkbox"/> Pitless adapter 12 Inches above grade	
				15. Well grouted? <input checked="" type="checkbox"/> X With: <input checked="" type="checkbox"/> Neat cement <input checked="" type="checkbox"/> Bentonite <input checked="" type="checkbox"/> Clay Depth: From 0 ft. to 10 ft.	
				16. Nearest source of possible contamination: ft. 1 mile Direction S Type Farmhouse Well disinfected upon completion? <input type="checkbox"/> Yes <input checked="" type="checkbox"/> No	
				17. Pump: <input checked="" type="checkbox"/> X Not installed Manufacturer's name Model number HP Volts Length of drop pipe ft. capacity g.p.m. Type: <input type="checkbox"/> Submersible <input type="checkbox"/> Turbine <input type="checkbox"/> Jet <input type="checkbox"/> Reciprocating <input type="checkbox"/> Centrifugal <input type="checkbox"/> Other	
18. Elevation:		19. Remarks:		20. Water well contractor's certification: This well was drilled under my jurisdiction and this report is true to the best of my knowledge and belief. Western Well & Well 245 Business name Address Box 852 Colby, KS 67701 License No. Signed John Renner Authorized representative Date	

Forward the white, blue and pink copies to the Department of Health and Environment

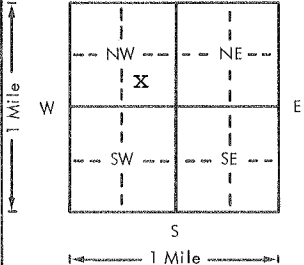
Form WWC-5

USE TYPEWRITER OR BALL
POINT PEN-PRESS FIRMLY,
PRINT CLEARLY.

WATER WELL RECORD
KSA 82a-1201-1215

Kansas Department of Health and
Environment-Division of Environment
(Water well Contractors)
Topeka, Kansas 66620

Pump Installation - Well #2 Job #46-77-B-23-9-32

1. Location of well:	County Thomas	Fraction SW 1/4 SE 1/4 NW 1/4	Section number 23	Township number T 9 S R 32 E/W	Range number
2. Distance and direction from nearest town or city: From Mingo; 1 South; 2 East; 1/2 South; 1/4 East Street address of well location if in city:			3. Owner of well: John Renner R.R. or street: City, state, zip code: Mingo, KS		
4. Locate with "X" in section below: N  W E S 1 Mile			Sketch map: 6. Bore hole dia. 30 in. Completion date 3-1-77 Well depth 203 ft. 7. <input type="checkbox"/> Cable tool <input type="checkbox"/> Rotary <input type="checkbox"/> Driven <input type="checkbox"/> Dug <input type="checkbox"/> Hollow rod <input type="checkbox"/> Jetted <input type="checkbox"/> Bored <input type="checkbox"/> Reverse rotary 8. Use: <input type="checkbox"/> Domestic <input type="checkbox"/> Public supply <input type="checkbox"/> Industry <input type="checkbox"/> Irrigation <input type="checkbox"/> Air conditioning <input type="checkbox"/> Stock <input type="checkbox"/> Lawn <input type="checkbox"/> Oil field water <input type="checkbox"/> Other 9. Casing: Material <input type="checkbox"/> Height: Above or below Threaded <input type="checkbox"/> Welded <input type="checkbox"/> Surface <input type="checkbox"/> in. RMP <input type="checkbox"/> PVC <input type="checkbox"/> Weight <input type="checkbox"/> lbs./ft. Dia. <input type="checkbox"/> in. to <input type="checkbox"/> ft. depth Wall Thickness: inches or Dia. <input type="checkbox"/> in. to <input type="checkbox"/> ft. depth gage No. <input type="checkbox"/>		
5. Type and color of material			From	To	10. Screen: Manufacturer's name <input type="checkbox"/> Type <input type="checkbox"/> Dia. <input type="checkbox"/> Slot/gauze <input type="checkbox"/> Length <input type="checkbox"/> Set between <input type="checkbox"/> ft. and <input type="checkbox"/> ft. <input type="checkbox"/> ft. and <input type="checkbox"/> ft. Gravel pack? <input type="checkbox"/> Size range of material <input type="checkbox"/> 11. Static water level: <input type="checkbox"/> mo./day/yr. <input type="checkbox"/> ft. below land surface Date <input type="checkbox"/> 12. Pumping level below land surfaces: <input type="checkbox"/> ft. after <input type="checkbox"/> hrs. pumping <input type="checkbox"/> g.p.m. <input type="checkbox"/> ft. after <input type="checkbox"/> hrs. pumping <input type="checkbox"/> g.p.m. Estimated maximum yield <input type="checkbox"/> g.p.m. 13. Water sample submitted: <input type="checkbox"/> mo./day/yr. <input type="checkbox"/> Yes <input type="checkbox"/> No Date <input type="checkbox"/> 14. Well head completion: <input type="checkbox"/> Pitless adapter <input type="checkbox"/> inches above grade 15. Well grouted? <input type="checkbox"/> With: <input type="checkbox"/> Neat cement <input type="checkbox"/> Bentonite <input type="checkbox"/> Concrete Depth: From <input type="checkbox"/> ft. to <input type="checkbox"/> ft. 16. Nearest source of possible contamination: ft. <input type="checkbox"/> Direction <input type="checkbox"/> Type <input type="checkbox"/> Well disinfected upon completion? <input type="checkbox"/> Yes <input type="checkbox"/> No 17. Pump: <input type="checkbox"/> Not installed Manufacturer's name Floway Model number 85259 HP 80 Volts <input type="checkbox"/> Length of drop pipe 190 ft. capacity <input type="checkbox"/> g.p.m. Type: 10" DOH bowl <input type="checkbox"/> Submersible <input checked="" type="checkbox"/> Turbine <input type="checkbox"/> Jet <input type="checkbox"/> Reciprocating <input type="checkbox"/> Centrifugal <input type="checkbox"/> Other
(Use a second sheet if needed)					
18. Elevation:	19. Remarks:		20. Water well contractor's certification: This well was drilled under my jurisdiction and this report is true to the best of my knowledge and belief. Western Well & Pump 245 Business name License No. Address Box 852 Colby, KS 67701 Signed Dale Berry Date 4/18/77 Authorized representative		
Topography: <input type="checkbox"/> Hill <input type="checkbox"/> Slope <input type="checkbox"/> Upland <input type="checkbox"/> Valley					

Forward the white, blue and pink copies to the Department of Health and Environment

Form WWC-5