

LOCATION OF WATER WELL:	Fraction	Section Number	Township Number	Range Number
County: Thomas	SE 1/4 SE 1/4 NW 1/4	23	T 9 S	R 32 E/W

Distance and direction from nearest town or city street address of well if located within city?

9 East 10 South of Colby, KS


WATER WELL OWNER:	John Renner Estate	Pickrell Drilling
-------------------	--------------------	-------------------

RR#, St. Address, Box # :
 City, State, ZIP Code : Oakley, KS 67748

Board of Agriculture, Division of Water Resources
 Application Number: T85-988

LOCATE WELL'S LOCATION WITH AN "X" IN SECTION BOX: 4 DEPTH OF COMPLETED WELL.....170..... ft. ELEVATION:

WELL'S STATIC WATER LEVEL 103 ft. below land surface measured on mo/day/yr 1-13-86

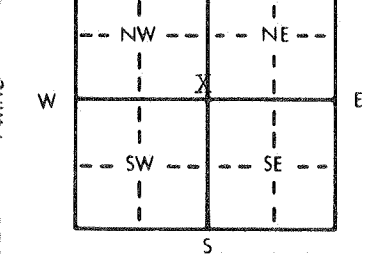

Pump test data: Well water was ft. after hours pumping gpm
 Est. Yield gpm: Well water was ft. after hours pumping gpm
 Bore Hole Diameter, in. to ft., and, in. to ft.
 WELL WATER TO BE USED AS: 5 Public water supply 8 Air conditioning 11 Injection well
 1 Domestic 3 Feedlot 6 Oil field water supply 9 Dewatering 12 Other (Specify below)
 2 Irrigation 4 Industrial 7 Lawn and garden only 10 Observation well
 Was a chemical/bacteriological sample submitted to Department? Yes.....No.....X....; If yes, mo/day/yr sample was sub-
 mitted Water Well Disinfected? Yes No X

TYPE OF BLANK CASING USED:		5 Wrought iron	8 Concrete tile	CASING JOINTS: Glued . <input checked="" type="checkbox"/> . . . Clamped
1 Steel	3 RMP (SR)	6 Asbestos-Cement	9 Other (specify below)	Welded
2 <u>PVC</u>	4 ABS	7 Fiberglass		Threaded
Blank casing diameter 5 in. to 150 ft. Dia in. to ft. Dia in. to ft.				
Casing height above land surface . 3' Below in., weight lbs./ft. Wall thickness or gauge No.				

TYPE OF SCREEN OR PERFORATION MATERIAL:			<u>7 PVC</u>	10 Asbestos-cement
1 Steel	3 Stainless steel	5 Fiberglass	8 RMP (SR)	11 Other (specify)
2 Brass	4 Galvanized steel	6 Concrete tile	9 ABS	12 None used (open hole)

SCREEN OR PERFORATION OPENINGS ARE:

1 Continuous slot	3 Mill slot	5 Gauzed wrapped	8 Saw cut	11 None (open hole)
2 Louvered shutter	4 Key punched	6 Wire wrapped	9 Drilled holes	
		7 Torch cut	10 Other (specify)	

GREEN-PERFORATED INTERVALS:	From 150	ft. to 170	ft., From	ft. to	ft.
	From	ft. to	ft., From	ft. to	ft.
GRAVEL PACK INTERVALS:	From	ft. to	ft., From	ft. to	ft.
	From	ft. to	ft., From	ft. to	ft.

GROUT MATERIAL: 1 Neat cement 2 Cement grout 3 Bentonite 4 Other
 Grout Intervals: From ft. to ft., From ft. to ft., From ft. to ft.

What is the nearest source of possible contamination:			10 Livestock pens	14 Abandoned water well
1 Septic tank	4 Lateral lines	7 Pit privy	11 Fuel storage	15 Oil well/Gas well
2 Sewer lines	5 Cess pool	8 Sewage lagoon	12 Fertilizer storage	16 Other (specify below)
3 Watertight sewer lines	6 Seepage pit	9 Feedyard	13 Insecticide storage

Direction from well? _____ How many feet? _____

[illegible]

CONTRACTOR'S OR LANDOWNER'S CERTIFICATION: This water well was (1) constructed, (2) reconstructed, or (3) plugged under my jurisdiction and was completed on (mo/day/year) 2-13-86 and this record is true to the best of my knowledge and belief. Kansas

Water Well Contractor's License No. 394 This Water Well Record was completed on (mo/day/yr) 9-11-86
under the business name of Woofter Pump & Well by (signature) Walter Walker

INSTRUCTIONS: Use typewriter or ball point pen, PLEASE PRESS FIRMLY and PRINT clearly. Please fill in blanks, underline or circle the correct answers. Send top three copies to Kansas Department of Health and Environment, Division of Environment, Environmental Geology Section, Topeka, KS 66620. Send one to WATER WELL OWNER and retain one for your records.