


LOCATION OF WATER WELL:	Fraction	Section Number	Township Number	Range Number
County: Thomas	NW ¼ NW ¼ SW ¼	23	T 9S S	R 32W EW

Distance and direction from nearest town or city street address of well if located within city?

8½ north ½ east of Oakley

WATER WELL OWNER:	Gesenhues Trust	Abercrombie Drilling Co.	
RR#, St. Address, Box # :		801 Union Center	Board of Agriculture, Division of Water Resources
City, State, ZIP Code :		Wichita, Ks. 67201	Application Number: T89 367

LOCATE WELL'S LOCATION WITH AN "X" IN SECTION BOX: 4 DEPTH OF COMPLETED WELL: 200 ft. ELEVATION: 114 ft. C. 114 ft. C. 114 ft. C.

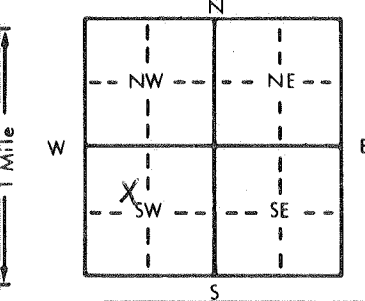

4. DEPTH OF COMPLETED WELL..... 200 ft. ELEVATION:
 Depth(s) Groundwater Encountered 1. NA ft. 2. ft. 3. ft.
 WELL'S STATIC WATER LEVEL 1.23 ft. below land surface measured on mo/day/yr
 Pump test data: Well water was ft. after hours pumping gpm
 Est. Yield gpm: Well water was ft. after hours pumping gpm
 Bore Hole Diameter..... in. to ft., and..... in. to ft.
 WELL WATER TO BE USED AS: 5 Public water supply 8 Air conditioning 11 Injection well
 1 Domestic 3 Feedlot 6 Oil field water supply 9 Dewatering 12 Other (Specify below)
 2 Irrigation 4 Industrial 7 Lawn and garden only 10 Monitoring well
 Was a chemical/bacteriological sample submitted to Department? Yes.....No.....☒; If yes, mo/day/yr sample was sub-
 mitted Water Well Disinfected? Yes No ☒

TYPE OF BLANK CASING USED:		5 Wrought iron	8 Concrete tile	CASING JOINTS: Glued Clamped
1 Steel	3 RMP (SR)	6 Asbestos-Cement	9 Other (specify below)	Welded
2 PVC	4 ABS	7 Fiberglass		Threaded

Blank casing diameter 4.5 in. to 200 ft., Dia. in. to ft., Dia. in. to ft.
Casing height above land surface. in., weight lbs./ft. Wall thickness or gauge No.

TYPE OF SCREEN OR PERFORATION MATERIAL:			7 PVC	10 Asbestos-cement
1 Steel	3 Stainless steel	5 Fiberglass	8 RMP (SR)	11 Other (specify)
2 Brass	4 Galvanized steel	6 Concrete tile	9 ABS	12 None used (open hole)

SCREEN OR PERFORATION OPENINGS ARE:		5 Gauzed wrapped	8 Saw cut	11 None (open hole)
1 Continuous slot	3 Mill slot	6 Wire wrapped	9 Drilled holes	
2 Louvered shutter	4 Key punched	7 Torch cut	10 Other (specify)	

SCREEN-PERFORATED INTERVALS:	From ft. to ft.,	From ft. to ft.
	From ft. to ft.,	From ft. to ft.
GRAVEL PACK INTERVALS:	From ft. to ft.,	From ft. to ft.
	From ft. to ft.,	From ft. to ft.

5] GROUT MATERIAL:		1 Neat cement		2 Cement grout		3 Bentonite		4 Other		
Grout Intervals:		From	6	ft. to	3	ft.	From	ft.	to	ft.

What is the nearest source of possible contamination:			10 Livestock pens	14 Abandoned water well
1 Septic tank	4 Lateral lines	7 Pit privy	11 Fuel storage	15 <u>Oil well</u> /Gas well
2 Sewer lines	5 Cess pool	8 Sewage lagoon	12 Fertilizer storage	16 Other (specify below)
3 Watertight sewer lines	6 Seepage pit	9 Feedyard	13 Insecticide storage	

Direction from well? South How many feet? 330'

[illegible]

7 CONTRACTOR'S OR LANDOWNER'S CERTIFICATION: This water well was (1) constructed, (2) reconstructed, or (3) plugged under my jurisdiction and was completed on (mo/day/year) 9-22-89 and this record is true to the best of my knowledge and belief. Kansas Water Well Contractor's License No. 394 This Water Well Record was completed on (mo/day/yr) 9-22-89 under the business name of _____ by (signature) [Signature]