

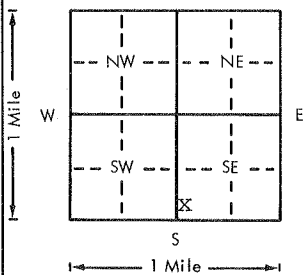
USE TYPEWRITER OR BALL
POINT PEN-PRESS FIRMLY,
PRINT CLEARLY.

WATER WELL RECORD
KSA 82a-1201-1215

Kansas Department of Health and
Environment-Division of Environment
(Water well Contractors)
Topeka, Kansas 66620

Well #2

DCC

1. Location of well:	County Thomas	Section number 24	Township number T 9 S	Range number R 32 E/W
2. Distance and direction from nearest town or city: From Colby; 10 South, 11½ East Street address of well location if in city:		3. Owner of well: Herb Maier R.R. or street: City, state, zip code: Oakley, Kansas		
4. Locate with "X" in section below: Sketch map: 		6. Bore hole dia. 30 in. Completion date 10-6-76 Well depth 187 ft.		
5. Type and color of material		7. <input type="checkbox"/> Cable tool <input type="checkbox"/> Rotary <input type="checkbox"/> Driven <input type="checkbox"/> Dug <input type="checkbox"/> Hollow rod <input type="checkbox"/> Jetted <input checked="" type="checkbox"/> Bored <input checked="" type="checkbox"/> Reverse rotary		
Top Soil, Sandy Clay		8. Use: <input type="checkbox"/> Domestic <input type="checkbox"/> Public supply <input type="checkbox"/> Industry <input checked="" type="checkbox"/> Irrigation <input type="checkbox"/> Air conditioning <input type="checkbox"/> Stock <input type="checkbox"/> Lawn <input type="checkbox"/> Oil field water <input type="checkbox"/> Other		
Sandy Clay, Coarse Sand		9. Casing: Material Steel Height: Above or below XXXX Threaded <input type="checkbox"/> Welded <input checked="" type="checkbox"/> Surface 12 in. RMP <input type="checkbox"/> PVC <input type="checkbox"/> Weight .188 lbs./ft. Dia. 16 in. to 97 ft. depth Wall Thickness: inches or Dia. <input type="checkbox"/> in. to <input type="checkbox"/> ft. depth gage No. #7		
Sandy Clay, Coarse Sand		10. Screen: Manufacturer's name Brown Type Regular Dia. 16" Slot/gauze 10% Length 80' Set between 97 ft. and 177 ft. 10' Cook 177 ft. and 187 ft.		
Coarse Sand, Med. Gravel		11. Static water level: 83 ft. below land surface Date 10-8-76		
Coa. Sand, Clay Streaks, Coa. Sand		12. Pumping level below land surfaces: 182 ft. after 2 hrs. pumping 1120 g.p.m. 182 ft. after 2 hrs. pumping 1120 g.p.m. Estimated maximum yield 1120 g.p.m.		
Sandy Clay, Coa. Sand Streaks, Sand Stone Streaks		13. Water sample submitted: mo./day/yr. <input type="checkbox"/> Yes <input checked="" type="checkbox"/> No Date 10-8-76		
Sandy Clay, Sand Stone Steaks, Coa. Sand, Sm.Gr.		14. Well head completion: <input type="checkbox"/> Pitless adapter 12 inches above grade		
Coa. Med. Sand, Clay St., Sandstone St., Coa. Sand		15. Well grouted? <input checked="" type="checkbox"/> Clay With: <input checked="" type="checkbox"/> Neat cement <input checked="" type="checkbox"/> Bentonite <input checked="" type="checkbox"/> Concrete Depth: From 0 ft. to 10 ft.		
Med. Coa. Sand, Small Gravel		16. Nearest source of possible contamination: ft. 5280 Direction NE Type Farm Well disinfected upon completion? <input type="checkbox"/> Yes <input checked="" type="checkbox"/> No		
Med. Coa. Sand, Small Gravel		17. Pump: <input type="checkbox"/> Not installed Manufacturer's name Floway Model number 056208 HP 80 Volts 240 Length of drop pipe 182 ft. capacity 700 g.p.m. Type: <input checked="" type="checkbox"/> Submersible <input checked="" type="checkbox"/> Turbine <input type="checkbox"/> Jet <input type="checkbox"/> Reciprocating <input type="checkbox"/> Centrifugal <input type="checkbox"/> Other		
Ochre, Shale		20. Water well contractor's certification: This well was drilled under my jurisdiction and this report is true to the best of my knowledge and belief. Western Well & Pump 245 Business name License No. Address Box 852, Colby, KS 67701 Signed Billy Berry Date 10-29-76 Authorized representative		
18. Elevation:		19. Remarks: BROCK 181'		
Topography: <input type="checkbox"/> Hill <input type="checkbox"/> Slope <input checked="" type="checkbox"/> Upland <input type="checkbox"/> Valley				

Forward the white, blue and pink copies to the Department of Health and Environment

Form WWC-5