


1 LOCATION OF WATER WELL:	Fraction $\frac{SW}{4}$ $\frac{SE}{4}$ $\frac{NW}{4}$	Section Number 25	Township Number T 9 S	Range Number R 32 EW
---------------------------	---	-------------------	-----------------------	----------------------

WATER WELL OWNER: M. W. P. Drilling

LOCATE WELL'S LOCATION WITH AN "X" IN SECTION BOX: 4 DEPTH OF COMPLETED WELL: 180 ft. ELEVATION: \_\_\_\_\_

Depth(s) Groundwater Encountered 1. 85 ft. 2. \_\_\_\_\_ ft. 3. \_\_\_\_\_ ft.

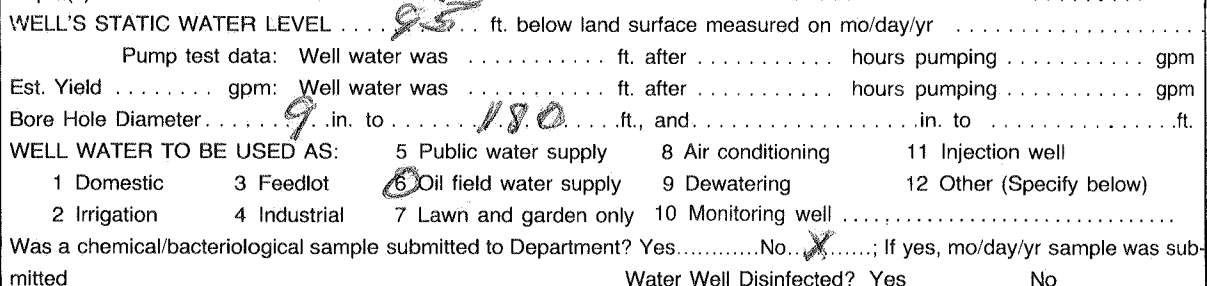

Blank casing diameter . . . . . 5 in. to 180 ft., Dia . . . . . in. to . . . . . ft., Dia . . . . . in. to . . . . . ft.  
Casing height above land surface . . . . . 18 in., weight . . . . . 250 lbs./ft. Wall thickness or gauge No. . . . . 250

SCREEN OR PERFORATION OPENINGS ARE:

<input checked="" type="radio"/> Continuous slot	<input type="radio"/> Mill slot	5 Gauzed wrapped	8 Saw cut	11 None (open hole)
<input type="radio"/> Louvered shutter	<input type="radio"/> Key punched	6 Wire wrapped	9 Drilled holes	
		7 Torch cut	10 Other (specify) .....	

SCREEN-PERFORATED INTERVALS: From 170 ft. to 180 ft., From . ft. to . ft.  
From . ft. to . ft., From . ft. to . ft.  
GRAVEL PACK INTERVALS: From 95 ft. to 180 ft., From . ft. to . ft.  
From . ft. to . ft. From . ft. to . ft.

6] GROUT MATERIAL: 1 Neat cement      2 Cement grout      3 Bentonite      4 Other .....

Grout Intervals: From 00 ft. to 20 ft. From ..... ft. to ..... ft. From ..... ft. to ..... ft.

What is the nearest source of possible contamination:			10 Livestock pens	14 Abandoned water well
1 Septic tank	4 Lateral lines	7 Pit privy	11 Fuel storage	15 Oil well/Gas well
2 Sewer lines	5 Cess pool	8 Sewage lagoon	12 Fertilizer storage	16 Other (specify below)
3 Watertight sewer lines	6 Seepage pit	9 Feedyard	13 Insecticide storage	<i>Drawn</i>
Direction from well? <i>South</i>			How many feet?	<i>500</i>

[illegible]

7. CONTRACTOR'S OR LANDOWNER'S CERTIFICATION: This water well was (1) constructed, (2) reconstructed, or (3) plugged under my jurisdiction and was completed on (mo/day/year) 7-7-89 and this record is true to the best of my knowledge and belief. Kansas Water Well Contractor's License No. 374 This Water Well Record was completed on (mo/day/yr) 10-7-89 under the business name of B+B Drilling by (signature) Joseph Beckman