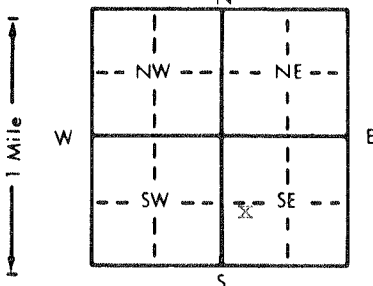


1 LOCATION OF WATER WELL:	Fraction	Section Number	Township Number	Range Number
County: Thomas	NW 1/4 SW 1/4 SE 1/4	19	T 9 S	R 33 E/W

Distance and direction from nearest town or city street address of well if located within city?

10 south and 1/4 east of Colby KS

2 WATER WELL OWNER: Berry Kaaz	Board of Agriculture, Division of Water Resources
RR#, St. Address, Box # : Rt 2 Box 440	Application Number:
City, State, ZIP Code: Colby, KS 67701	

3 LOCATE WELL'S LOCATION WITH AN "X" IN SECTION BOX:	4 DEPTH OF COMPLETED WELL: 250 ft. ELEVATION:
	Depth(s) Groundwater Encountered 1. ft. 2. ft. 3. ft.
	WELL'S STATIC WATER LEVEL 166 ft. below land surface measured on mo/day/yr 8-27-97
	Pump test data: Well water was ft. after hours pumping gpm
	Est. Yield gpm: Well water was not tested after hours pumping gpm
	Bore Hole Diameter 8 in. to 250 ft., and in. to ft.
	WELL WATER TO BE USED AS:
	1 Domestic 3 Feedlot 6 Oil field water supply 9 Dewatering 12 Other (Specify below)
	2 Irrigation 4 Industrial 7 Lawn and garden only 10 Monitoring well
	Was a chemical/bacteriological sample submitted to Department? Yes No X; If yes, mo/day/yr sample was submitted
	Water Well Disinfected? Yes X No

5 TYPE OF BLANK CASING USED:	5 Wrought iron	8 Concrete tile	CASING JOINTS: Glued X Clamped
1 Steel	3 RMP (SR)	6 Asbestos-Cement	9 Other (specify below)
2 PVC	4 ABS	7 Fiberglass	10 Asbestos-cement
Blank casing diameter 5 in. to 230 ft., Dia			11 Other (specify)
Casing height above land surface 18 in., weight 2.6 lbs./ft.			12 None used (open hole)
TYPE OF SCREEN OR PERFORATION MATERIAL:			
1 Steel	3 Stainless steel	5 Fiberglass	8 RMP (SR)
2 Brass	4 Galvanized steel	6 Concrete tile	9 ABS
SCREEN OR PERFORATION OPENINGS ARE:			
1 Continuous slot	3 Mill slot	5 Gauzed wrapped	8 Saw cut
2 Louvered shutter	4 Key punched	6 Wire wrapped	9 Drilled holes
7 Torch cut			10 Other (specify)
SCREEN-PERFORATED INTERVALS:			
From 230 ft. to 250 ft.			
GRAVEL PACK INTERVALS:			
From 18 ft. to 250 ft.			

6 GROUT MATERIAL:	1 Neat cement	2 Cement grout	3 Bentonite	4 Other
Grout Intervals: From 4 ft. to 18 ft.				
What is the nearest source of possible contamination:				
1 Septic tank	4 Lateral lines	7 Pit privy	10 Livestock pens	14 Abandoned water well
2 Sewer lines	5 Cess pool	8 Sewage lagoon	11 Fuel storage	15 Oil well/Gas well
3 Watertight sewer lines	6 Seepage pit	9 Feedyard	12 Fertilizer storage	16 Other (specify below)
Direction from well?				

FROM	TO	LITHOLOGIC LOG	FROM	TO	PLUGGING INTERVALS
0	40	top soil			
40	82	sandy clay			
82	100	sand and clay strips			
100	118	sand and sand rock strips			
118	135	sand and clay strips			
135	140	sand rock hard			
140	155	sand			
155	188	sand and sand rock strips			
188	195	sand rock hard			
195	222	sand and sand rock strips			
222	234	sand clay and sand strips			
234	248	sand good			
248	250	oker and shale			

7 CONTRACTOR'S OR LANDOWNER'S CERTIFICATION: This water well was (1) constructed, (2) reconstructed, or (3) plugged under my jurisdiction and was completed on (mo/day/year) 8-27-97 and this record is true to the best of my knowledge and belief. Kansas Water Well Contractor's License No. 139 This Water Well Record was completed on (mo/day/yr) 6-25-98 under the business name of Bartell Drilling by (signature) Jose Bartell
