

**WATER WELL PLUGGING RECORD Form WWC-5P**

KSA 82a-1212

ID NO.

261

**1 LOCATION OF WATER WELL:** Fraction NE 1/4 NE 1/4 NE 1/4 NE 1/4 Section Number 14 Township Number T 9 S Range Number 33  E  W  
 County: Thomas

Street/Rural Address of Well Location; if unknown, distance & direction from nearest town or intersection: If at owner's address, check here

**Global Positioning Systems (GPS) Information:**

Latitude: 39.27781 (in decimal degrees)  
 Longitude: 100.96336 (in decimal degrees)

Elevation: \_\_\_\_\_  
 Datum:  WGS84,  NAD83,  NAD27


**Collection Method:**

GPS unit (Make/Model: Garmin Etrex 10)  
 Digital Map/Photo,  Topographic Map,  Land Survey

Est. Accuracy:  <3 m,  3-5 m,  5-15 m,  >15 m

**2 WATER WELL OWNER:** Mingo Bible Church  
 RR#, St. Address, Box #: 420 Main Mingo Street  
 City, State ZIP Code: Colby, KS 67701

**3 MARK WELL'S LOCATION WITH AN "X" IN SECTION BOX:**

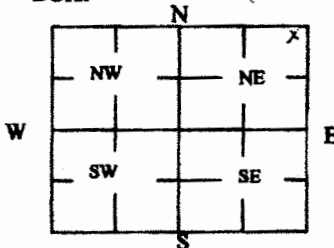

**4 DEPTH OF WELL** 156 ft.

WELL'S STATIC WATER LEVEL: 139 ft

**WELL WAS USED AS:**

- Domestic Irrigation
- Public Water Supply
- Dewatering
- Feedlot
- Oil Field Water Supply
- Monitoring
- Industrial
- Domestic (Lawn & Garden)
- Injection Well
- Air Conditioning
- Other \_\_\_\_\_

Was a chemical/bacteriological sample submitted to Department? Yes  No

**5 TYPE OF BLANK CASING USED:**

- Steel
- PVC
- RMP (SR)
- ABS
- Wrought
- Asbestos-Cement
- Fiberglass
- Concrete Tile
- Other (Specify below) \_\_\_\_\_

Blank casing diameter 5" in. Was casing pulled? Yes  No  If yes, how much \_\_\_\_\_  
 Casing height above or (below) land surface 38 in.

**6 GROUT PLUG MATERIAL:**  Neat cement  Cement grout  Bentonite  Other \_\_\_\_\_

Grout Plug Intervals: From 115 ft to 110 ft, From 11 ft to 6 ft, From 6 ft to 3 ft.

What is the nearest source of possible contamination: Bentonite

- Septic tank
- Sewer lines
- Watertight sewer lines
- Lateral lines
- Cess pool
- Seepage pit
- Pit privy
- Sewage lagoon
- Feedyard
- Livestock pens
- Fuel storage
- Fertilizer storage
- Insecticide storage
- Abandoned water well
- Oil well/Gas well
- Other (specify below) \_\_\_\_\_

Direction from well? W  
 How many feet? 50'

FROM	TO	PLUGGING MATERIALS	FROM	TO	PLUGGING MATERIALS
156	115	Clay			
115	110	Bentonite			
110	11	Clay			
11	6	Bentonite			
6	3	Cement Grout			
3	0	Compacted Clay & Topsoil			

**7 CONTRACTOR'S OR LANDOWNER'S CERTIFICATION:** This water well was plugged under my jurisdiction and was completed on (mo/day/year) 3-17-16 and this record is true to the best of my knowledge and belief. Kansas Water Well Contractor's License No. 463. This Water Well Record was completed on (mo/day/year) 3-25-16 under the business name of Brenn Pump & Supply by (signature) [Signature]

**INSTRUCTIONS:** Use typewriter or ballpoint pen. Please press firmly and print clearly. Please fill in blanks, underline or circle the correct answers. Send top three copies to Kansas Department of Health and Environment, Bureau of Water, Geology Section, 1000 SW Jackson St., Ste. 420, Topeka, Kansas 66612-1367. Telephone: 785/296-5524. Send one to Water Well Owner and retain one for your records. Visit us at <http://www.kdheks.gov/waterwell/index.html>.