USE TYPEWRITER OR BALL POINT PEN-PRESS FIRMLY, PRINT CLEARLY.

WATER WELL RECORD
KSA 82a-1201-1215

DBB

Kansas Department of Health and Environment-Division of Environment
(Water well Contractors)
Topeka, Kansas 66620

1. Location of well:	County	Fraction	Section number	Township number	Range number
	Thomas	NW 1/4 NW 1/4 SE 1/4	6	T 9 S	R 33 E/(W)

2. Distance and direction from nearest town or city:
6 So. Colby
Street address of well location if in city:

3. Owner of well: Ronald Stramel
R.R. or street: RR1 Box 22
City, state, zip code: Colby, Kansas 67701

4. Locate with "X" in section below:

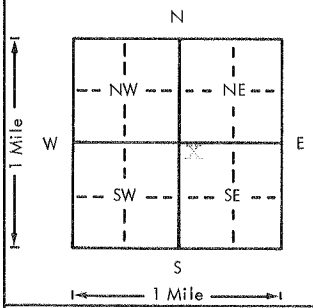

Sketch map:

6. Bore hole dia. 8 in. Completion date
Well depth 208 ft. 10-26-76

7. __ Cable tool X Rotary __ Driven __ Dug
__ Hollow rod __ Jetted __ Bored __ Reverse rotary

8. Use: __ Domestic __ Public supply __ Industry
__ Irrigation __ Air conditioning X Stock
__ Lawn __ Oil field water __ Other

9. Casing: Material pl st
Threaded __ Welded 91
RMP X PVC __
Dia. 5 in. to 208 ft. depth
Dia. __ in. to __ ft. depth
Height: Above or below Surface 15 in.
Weight __ lbs./ft.
Wall Thickness: inches or gage No. .025

10. Screen: Manufacturer's name J and L
Type RMP Dia. 5"
Slot/gauze 1/32" Length 20'
Set between 188 ft. and 208 ft.
__ ft. and __ ft.
Gravel pack? yes Size range of material 1/8"

11. Static water level: mo./day/yr.
130 ft. below land surface Date

12. Pumping level below land surfaces:
__ ft. after NA hrs. pumping __ g.p.m.
__ ft. after __ hrs. pumping __ g.p.m.
Estimated maximum yield __ g.p.m.

13. Water sample submitted: mo./day/yr.
__ Yes X No Date

14. Well head completion:
no Pitless adapter x/4 Inches above grade

15. Well grouted? yes
With: __ Neat cement X Bentonite __ Concrete
Depth: From 4 ft. to 18 ft.

16. Nearest source of possible contamination:
ft. __ Direction NA Type
Well disinfected upon completion? X Yes __ No

17. Pump: X Not installed
Manufacturer's name
Model number HP Volts
Length of drop pipe ft. capacity g.p.m.
Type:
__ Submersible __ Turbine
__ Jet __ Reciprocating
__ Centrifugal __ Other

5. Type and color of material	From	To
Top Soil	0	43
Sand	42	55
Sand and Sandy Clay Strips	55	142
Sand Rock	142	157
Sand and Sand Rock Strips	157	176
Sand Good	176	191
Sand Clay	191	194
Sand Good	194	201
Oker	201	208
BROCK 201'		

(Use a second sheet if needed)

18. Elevation:

Topography:
__ Hill
X Slope
__ Upland
__ Valley

19. Remarks:
This is a windmill well.

20. Water well contractor's certification:
This well was drilled under my jurisdiction and this report is true to the best of my knowledge and belief.
Bartell Drilling 139
Business name License No.
Address Winona, Kansas 67764
Signed Joyce Bartell Date 11/22/77
Authorized representative

T 9 R 33 (W) Sec 6 1/4 NW 1/4 NW 1/4 NW 1/4 SE

Forward the white, blue and pink copies to the Department of Health and Environment

Form WWC-5

MI-1023