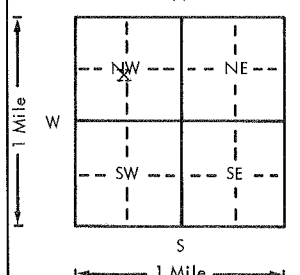


USE TYPEWRITER OR BALL
POINT PEN-PRESS FIRMLY,
PRINT CLEARLY.

WATER WELL RECORD
KSA 82a-1201-1215

Kansas Department of Health and
Environment-Division of Environment
(Water well Contractors)
Topeka, Kansas 66620

| | | | | | | |
|---|-------------------------|---|--|--------------------------------------|---|------------|
| 1. Location of well: | County Thomas | Fraction NE 1/4 SW 1/4 NW 1/4 | Section number 16 | Township number T 9 S R 33 | Range number 33 | X W |
| 2. Distance and direction from nearest town or city: 2 3/4 West; 1/4 South Street address of well location if in city: | | | 3. Owner of well: Don Friesen R.R. or street: City, state, zip code: Mingo, Kansas | | | |
| 4. Locate with "X" in section below:  | | | Sketch map: | | | |
| 5. Type and color of material | | | From | To | 6. Bore hole dia. 36 in. Completion date 10-2-76 Well depth 246 ft. | |
| Clay | | | 0 | 35 | 7. <input type="checkbox"/> Cable tool <input type="checkbox"/> Rotary <input type="checkbox"/> Driven <input type="checkbox"/> Dug <input type="checkbox"/> Hollow rod <input type="checkbox"/> Jetted <input type="checkbox"/> Bored <input checked="" type="checkbox"/> Reverse rotary | |
| Sand, Gravel | | | 35 | 58 | 8. Use: <input type="checkbox"/> Domestic <input type="checkbox"/> Public supply <input type="checkbox"/> Industry <input checked="" type="checkbox"/> Irrigation <input type="checkbox"/> Air conditioning <input type="checkbox"/> Stock <input type="checkbox"/> Lawn <input type="checkbox"/> Oil field water <input type="checkbox"/> Other | |
| Clay | | | 58 | 76 | 9. Casing: Material Steel Height: Above or below 12 in. Threaded <input type="checkbox"/> Welded <input checked="" type="checkbox"/> Surface 12 in. RMP <input type="checkbox"/> PVC <input type="checkbox"/> Weight 188 lbs./ft. Dia. 16 in. to 156 ft. depth Wall Thickness: inches or Dia. 16 in. to 75 ft. depth gauge No. #7 | |
| | | | | | 10. Screen: Manufacturer's name Brown Type Regular Dia. 16" Slot/gauze 10% Length 80' Set between 156 ft. and 236 ft. 10" Cook 236 ft. and 246 ft. Gravel pack? <input checked="" type="checkbox"/> Size range of material 1/2 x 5/8 50% #1 | |
| | | | 76 | 82 | 11. Static water level: 110 ft. below land surface Date 10-4-76 mo./day/yr. | |
| Clay, Sand, Gravel | | | 82 | 96 | 12. Pumping level below land surfaces: 246 ft. after 2 hrs. pumping 844 g.p.m. ft. after hrs. pumping g.p.m. Estimated maximum yield 844 g.p.m. | |
| Clay | | | 96 | 144 | 13. Water sample submitted: 10-4-76 mo./day/yr. Yes <input checked="" type="checkbox"/> No <input type="checkbox"/> Date | |
| Coarse Sand, Gravel | | | 144 | 168 | 14. Well head completion: <input type="checkbox"/> Pitless adapter 12 inches above grade | |
| Clay | | | 168 | 172 | 15. Well grouted? <input checked="" type="checkbox"/> Clay With: <input checked="" type="checkbox"/> Neat cement <input checked="" type="checkbox"/> Bentonite <input checked="" type="checkbox"/> Concrete Depth: From 0 ft. to 10 ft. | |
| Coarse Sand, Gravel | | | 172 | 180 | 16. Nearest source of possible contamination: 5000 ft. Direction NE Type Farm Well disinfected upon completion? Yes <input checked="" type="checkbox"/> No <input type="checkbox"/> | |
| Fine Coarse Sand | | | 180 | 193 | 17. Pump: Manufacturer's name Floway Not installed Model number 242 HP 100 Volts 480 Length of drop pipe 242 ft. capacity 600 g.p.m. Type: <input type="checkbox"/> Submersible <input checked="" type="checkbox"/> Turbine <input type="checkbox"/> Jet <input type="checkbox"/> Reciprocating <input type="checkbox"/> Centrifugal <input type="checkbox"/> Other | |
| Clay | | | 193 | 198 | | |
| Fine Coarse Sand | | | 198 | 231 | | |
| Coarse Sand, Gravel | | | 231 | 240 | | |
| Shale | | | 240 | 246 | | |
| BROCK 240' | | | | | | |
| (Use a second sheet if needed) | | | | | | |
| 18. Elevation: | 19. Remarks: | | 20. Water well contractor's certification: This well was drilled under my jurisdiction and this report is true to the best of my knowledge and belief. Western Well and Pump 245 Business name License No. Address Box 852, Colby, KS 67701 Signed Sally Berry Date 11/9/76 Authorized representative | | | |
| Topography: <input type="checkbox"/> Hill <input type="checkbox"/> Slope <input checked="" type="checkbox"/> Upland <input type="checkbox"/> Valley | | | | | | |

Forward the white, blue and pink copies to the Department of Health and Environment

Form WWC-5