

CORRECTED

WATER WELL RECORD Form WWC-5

Division of Water Resources App. No.

20160189

Well ID


Kistler 2-14

Original Record Correction Change in Well Use

1 LOCATION OF WATER WELL: County: Thomas Fraction NW 1/4 NE 1/4 NW 1/4 NE 1/4 Section Number 14 Township Number T 9 S Range Number R 34 E W

2 WELL OWNER: Last Name: Kistler First: Harvey Street or Rural Address where well is located intersection of Co Rd K & Co Rd 18

3 LOCATE WELL WITH "X" IN SECTION BOX:

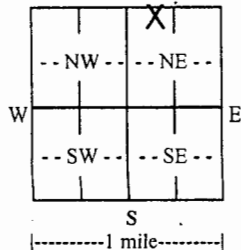

4 DEPTH OF COMPLETED WELL: 280 ft. Depth(s) Groundwater Encountered: 1) 105 ft. 2) 105 ft. 3) 105 ft. or 4) Dry Well

5 Latitude: 39.2779 Longitude: 101.0806 Datum: WGS 84 NAD 83 NAD 27 Source for Latitude/Longitude: GPS (unit make/model) (WAAS enabled? Yes No) Land Survey Topographic Map Online Mapper

6 Elevation: 3169 ft. Ground Level TOC Source: Land Survey GPS Topographic Map Other KOLAR

7 WELL WATER TO BE USED AS:

- 1. Domestic: Household Lawn & Garden Livestock Irrigation Feedlot Industrial
2. Public Water Supply: well ID
3. Dewatering: how many wells?
4. Aquifer Recharge: well ID
5. Monitoring: well ID
6. Environmental Remediation: well ID
7. Air Sparge Soil Vapor Extraction Recovery Injection
8. Oil Field Water Supply: lease Kistler #2-14
9. Test Hole: well ID Cased Uncased Geotechnical
10. Geothermal: how many bores?
a) Closed Loop Horizontal Vertical
b) Open Loop Surface Discharge Inj. of Water
11. Other (specify):

Was a chemical/bacteriological sample submitted to KDHE? Yes No If yes, date sample was submitted:
Water well disinfected? Yes No

8 TYPE OF CASING USED: Steel PVC Other CASING JOINTS: Glued Clamped Welded Threaded
Casing diameter 4.5 in. to 240 ft. Diameter in. to ft. Diameter in. to ft.
Casing height above land surface 18 in. Weight 2.38 lbs./ft. Wall thickness or gauge No. 237

TYPE OF SCREEN OR PERFORATION MATERIAL: Steel Stainless Steel Fiberglass PVC Other (Specify)
Brass Galvanized Steel Concrete tile None used (open hole)

SCREEN OR PERFORATION OPENINGS ARE: Continuous Slot Mill Slot Gauze Wrapped Torch Cut Drilled Holes Other (Specify)
Louvered Shutter Key Punched Wire Wrapped Saw Cut None (Open Hole)

SCREEN-PERFORATED INTERVALS: From 240 ft. to 280 ft. From ft. to ft. From ft. to ft. From ft. to ft.
GRAVEL PACK INTERVALS: From 20 ft. to 280 ft. From ft. to ft. From ft. to ft. From ft. to ft.

9 GROUT MATERIAL: Neat cement Cement grout Bentonite Other
Grout Intervals: From 0 ft. to 20 ft. From ft. to ft. From ft. to ft. From ft. to ft.

Nearest source of possible contamination: Septic Tank Lateral Lines Pit Privy Livestock Pens Insecticide Storage
Sewer Lines Cess Pool Sewage Lagoon Fuel Storage Abandoned Water Well
Watertight Sewer Lines Seepage Pit Feedyard Fertilizer Storage Oil Well/Gas Well
Other (Specify)
Direction from well? Distance from well? ft.

Table with columns: 10 FROM TO LITHOLOGIC LOG FROM TO LITHO. LOG (cont.) or PLUGGING INTERVALS. Rows: 0-2 surface, 2-20 loess, 20-43 clay w/caliche lenses, 43-62 fine & med sand & gravel w/clay & caliche, 62-262 fine & med sand w/clay & caliche strks, 262-280 black shale.

Notes:

11 CONTRACTOR'S OR LANDOWNER'S CERTIFICATION: This water well was constructed, reconstructed, or plugged under my jurisdiction and was completed on (mo-day-year) 10/06/2016 and this record is true to the best of my knowledge and belief. Kansas Water Well Contractor's License No. 881 This Water Well Record was completed on (mo-day-year) 10/24/2016 under the business name of Woofert Pump and Well, Inc.

Send one copy to WATER WELL OWNER and retain one for your records. Fee of \$5.00 for each constructed well.

KS Department of Health and Environment, Bureau of Water, Geology Section, 1000 SW Jackson St., Suite 420, Topeka, Kansas 66612-1367. Telephone 785-296-3565.

Visit us at http://www.kdheks.gov/waterwell/index.html

KSA 82a-1212

Woofter Pump & Well, Inc.
1024 Oak Ave., P. O. Box 689, Hoxie, KS 67740
PH: 785-675-3991, FAX: 785-675-3990
Email Woofpw@ruraltel.net

June 18, 2019


KDHE, Bureau of Water:

Please make changes to current WWC5 file # 20160189 as indicated below.

Well owner should be changed to:

Slawson Exploration
204 N. Robinson Ave, Suite 2300
Oklahoma City, OK 73102

Thank you,

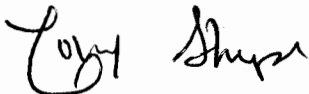

Coleen Shepard
Woofter Pump & Well, Inc.



ASSIGNMENT OF WATER WELL TO LANDOWNER

I, Harvey Kistler of 1046 Co Rd 18
(Landowner's address)

Colby KS
(City) (State) am the landowner on which a water well is located in the

NW quarter of the NE quarter of the NW quarter of the NE quarter of Section 14,
Township 9 S, Range 34W E/W, in Thomas County, Kansas which is approximately
127' FNL feet north/south, and 1805 FEL feet east/west of the apparent NE section corner.

The water well was drilled in 10/2016 (month/year).

I hereby request that Slawson Exploration Company Inc.
(Well operator/owner name) leave the water well,

which was drilled under Temporary/Term Water Permit # 20160189, unplugged, and I will
assume all responsibility for the plugging of said water well in accordance with the requirements of the
Kansas Department of Health and Environment regulation K.A.R. 28-30-7.

LANDOWNER:

Harvey Kistler 12-19-2019
(Signature) (Date)

Harvey S. Kistler
(Print)

WELL OWNER:

[Signature] 12-12-19
(Signature) (Date)

By: Gary Wyatt Manager
(Agent)

IF ADDITIONAL LANDOWNER

(Signature) (Date)

(Print)