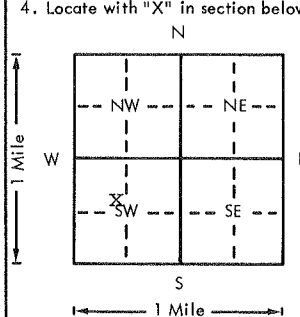


USE TYPEWRITER OR BALL  
POINT PEN-PRESS FIRMLY  
PRINT CLEARLY.

WATER WELL RECORD  
KSA 82a-1201-1215

Kansas Department of Health and  
Environment-Division of Environment  
(Water well Contractors)  
Topeka, Kansas 66620

1. Location of well:		County <b>Thomas</b>	Fraction <b>SE 1/4 NW 1/4 SW 1/4</b>	Section number <b>#4</b>	Township number <b>T 9 S R 34</b>	Range number <b>34</b>
2. Distance and direction from nearest town or city: <b>From Colby, Ks., 4 miles West &amp; 6 1/2 miles South</b> Street address of well location if in city:				3. Owner of well: <b>Joe McIlnay</b> R.R. or street: City, state, zip code: <b>Colby, Kansas 67701</b>		
4. Locate with "X" in section below:		Sketch map:				
						
5. Type and color of material			From	To		
Clay & sand streaks			0	145		
Fine to coarse sand & gravel			145	155		
Sandy clay & cemented streaks			155	161		
Fine to coarse sand & gravel			161	172		
Sandy clay			172	178		
Fine to coarse sand & gravel			178	191		
Sandy clay			191	201		
Fine to coarse sand & gravel			201	218		
Cemented sand			218	219		
Fine to coarse sand & gravel			219	235		
Cemented sandy clay			235	239		
Fine to coarse sand & gravel			239	266		
Shale			266	---		
BROCK 266'						
(Use a second sheet if needed)						
18. Elevation:	19. Remarks: <b>3252 (TOPO)</b>					
Topography: <input type="checkbox"/> Hill <input type="checkbox"/> Slope <input checked="" type="checkbox"/> Upland <input type="checkbox"/> Valley						
6. Bore hole dia. <b>30</b> in. Completion date <b>11-4-75</b> Well depth <b>266</b> ft.			7. <input type="checkbox"/> Cable tool <input type="checkbox"/> Rotary <input type="checkbox"/> Driven <input type="checkbox"/> Dug <input type="checkbox"/> Hollow rod <input type="checkbox"/> Jetted <input type="checkbox"/> Bored <input checked="" type="checkbox"/> Reverse rotary			
8. Use: <input type="checkbox"/> Domestic <input type="checkbox"/> Public supply <input type="checkbox"/> Industry <input checked="" type="checkbox"/> Irrigation <input type="checkbox"/> Air conditioning <input type="checkbox"/> Stock <input type="checkbox"/> Lawn <input type="checkbox"/> Oil field water <input type="checkbox"/> Other			9. Casing: Material <b>steel</b> Height: <b>Above</b> or below Threaded <input type="checkbox"/> Welded <input checked="" type="checkbox"/> Surface <b>12</b> in. RMP <input type="checkbox"/> PVC <input type="checkbox"/> Weight <b>.188</b> lbs./ft. Dia. <b>16</b> in. to <b>176</b> ft. depth Wall Thickness: <b>#7</b> inches or Dia. <b>16</b> in. to <b>176</b> ft. depth gauge No. <b>7</b>			
10. Screen: Manufacturer's name <b>W. A. Brown</b> Type <b>regular</b> Dia. <b>16"</b> Slot/gauze <b>10%</b> Length <b>80'</b> Set between <b>176'</b> ft. and <b>256'</b> ft. <b>10' of cook</b> ft. and <b>266'</b> ft. Gravel pack? <b>yes</b> Size range of material <b>1/4 x 5/8</b>			11. Static water level: <b>165'</b> ft. below land surface Date <b>11-5-75</b> mo./day/yr.			
12. Pumping level below land surfaces: <b>191'</b> ft. after <b>2</b> hrs. pumping <b>1100</b> g.p.m. ft. after <b>2</b> hrs. pumping <b>1400</b> g.p.m. Estimated maximum yield <b>1400</b> g.p.m.			13. Water sample submitted: <b>Yes</b> <input checked="" type="checkbox"/> No <input type="checkbox"/> Date <b>11-5-75</b> mo./day/yr.			
14. Well head completion: <b>12</b> inches above grade <input type="checkbox"/> Pitless adapter			15. Well grouted? <b>yes</b> & clay With: <input type="checkbox"/> Neat cement <input checked="" type="checkbox"/> Bentonite <input type="checkbox"/> Concrete Depth: From <b>0</b> ft. to <b>10</b> ft.			
16. Nearest source of possible contamination: ft. <b>2000'</b> Direction <b>NW</b> Type <b>Farm</b> Well disinfected upon completion? <b>Yes</b> <input checked="" type="checkbox"/> No <input type="checkbox"/>			17. Pump: <b>Not installed</b> Manufacturer's name <b>Floway</b> Model number <b>10 DOH</b> HP <b>100</b> Volts <b>---</b> Length of drop pipe <b>260</b> ft. capacity <b>550</b> g.p.m. Type: <input type="checkbox"/> Submersible <input checked="" type="checkbox"/> Turbine <input type="checkbox"/> Jet <input type="checkbox"/> Reciprocating <input type="checkbox"/> Centrifugal <input type="checkbox"/> Other			
20. Water well contractor's certification: This well was drilled under my jurisdiction and this report is true to the best of my knowledge and belief. <b>Western Well &amp; Pump, Inc. 245</b> Business name <b>P.O. Box 852, Colby, Ks.</b> License No. <b>---</b> Address <b>Roy E. Senior</b> Date <b>Jan 14</b> Signed <b>Roy E. Senior</b> Authorized representative						

Forward the white, blue and pink copies to the Department of Health and Environment

Form WW-5