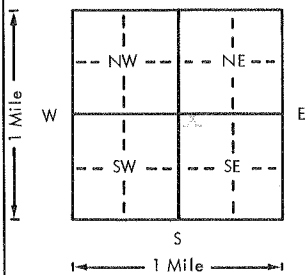


USE TYPEWRITER OR BALL
POINT PEN-PRESS FIRMLY,
PRINT CLEARLY.

WATER WELL RECORD
KSA 82a-1201-1215

Kansas Department of Health and
Environment-Division of Environment
(Water well Contractors)
Topeka, Kansas 66620

1. Location of well:		County Thomas	Fraction NW 1/4 NW 1/4 SE 1/4	Section number 6	Township number T 9 S R 34 E/W	Range number
2. Distance and direction from nearest town or city: 4W, 6S, 1W of Colby Street address of well location if in city:				3. Owner of well: Bill Keck R.R. or street: Colby, Kansas 67701 City, state, zip code:		
4. Locate with "X" in section below:		Sketch map:		6. Bore hole dia. 1 in. Completion date 12-15-76 Well depth 210 ft.		
				7. <input type="checkbox"/> Cable tool <input checked="" type="checkbox"/> Rotary <input type="checkbox"/> Driven <input type="checkbox"/> Dug <input type="checkbox"/> Hollow rod <input type="checkbox"/> Jetted <input type="checkbox"/> Bored <input type="checkbox"/> Reverse rotary		
5. Type and color of material		From	To	8. Use: <input checked="" type="checkbox"/> Domestic <input type="checkbox"/> Public supply <input type="checkbox"/> Industry <input type="checkbox"/> Irrigation <input type="checkbox"/> Air conditioning <input type="checkbox"/> Stock <input type="checkbox"/> Lawn <input type="checkbox"/> Oil field water <input type="checkbox"/> Other		
Top Soil		0	52	9. Casing: Material Plat Height: Above or below Threaded <input type="checkbox"/> Welded <input type="checkbox"/> Surface 15 in. RMP <input checked="" type="checkbox"/> PVC <input type="checkbox"/> Weight <input type="checkbox"/> lbs./ft. Dia. 5 in. to 210 ft. depth Wall Thickness: inches or Dia. <input type="checkbox"/> in. to <input type="checkbox"/> ft. depth gauge No. 14		
Sand Clay		52	107	10. Screen: Manufacturer's name J and L Type RMP Dia. 5 1/2 Slot/gauze 1/32 Length 20' Set between 190 ft. and 210 ft. ft. and ft. Gravel pack? yes Size range of material 1/8"		
Sand and Sand Rock Strips		107	187	11. Static water level: 137 ft. below land surface Date 12-15-76		
Sand Clay		187	198	12. Pumping level below land surfaces: ft. after NA hrs. pumping g.p.m. ft. after NA hrs. pumping g.p.m. Estimated maximum yield g.p.m.		
Sand		198	210	13. Water sample submitted: no mo./day/yr. Yes <input checked="" type="checkbox"/> No <input type="checkbox"/> Date		
Shale		210		14. Well head completion: no Pitless adapter no inches above grade		
BROCK 210				15. Well grouted? yes With: <input type="checkbox"/> Neat cement <input checked="" type="checkbox"/> Bentonite <input type="checkbox"/> Concrete Depth: From 1 ft. to 10 ft.		
				16. Nearest source of possible contamination: ft. Direction NA Type NA Well disinfected upon completion? <input type="checkbox"/> Yes <input type="checkbox"/> No		
				17. Pump: <input checked="" type="checkbox"/> Not installed Manufacturer's name Barrell Model number 130 HP 1/4 Volts 115 Length of drop pipe 10 ft. capacity 10 g.p.m. Type: <input type="checkbox"/> Submersible <input type="checkbox"/> Turbine <input type="checkbox"/> Jet <input type="checkbox"/> Reciprocating <input type="checkbox"/> Centrifugal <input type="checkbox"/> Other		
18. Elevation:		19. Remarks:		20. Water well contractor's certification: This well was drilled under my jurisdiction and this report is true to the best of my knowledge and belief. Barrell Drilling 130 Business name License No. Address Winona, Kansas 67764 Signed James Barrell Date 4/77 Authorized representative		
Topography: <input type="checkbox"/> Hill <input type="checkbox"/> Slope <input checked="" type="checkbox"/> Upland <input type="checkbox"/> Valley		This was a windmill well.				

Forward the white, blue and pink copies to the Department of Health and Environment

Form WWC-5