

1 LOCATION OF WATER WELL:	Fraction	Section Number	Township Number	Range Number
County: <u>THOMAS</u>	<u>SW 1/4 NW 1/4 SW 1/4</u>	<u>14</u>	T <u>9</u> S	R <u>34</u> E/W

Distance and direction from nearest town or city street address of well if located within city?

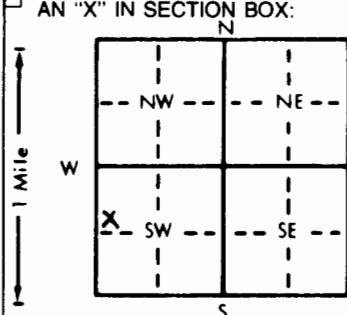
2 WATER WELL OWNER: Wilma Towns (Pabst)RR#, St. Address, Box # : Rt 1

Board of Agriculture, Division of Water Resources

City, State, ZIP Code : Colby KS 67701

Application Number:

3 LOCATE WELL'S LOCATION WITH AN "X" IN SECTION BOX:

4 DEPTH OF COMPLETED WELL: 150 ft. ELEVATION:

Depth(s) Groundwater Encountered 1. ft. 2. ft. 3. ft.

WELL'S STATIC WATER LEVEL Dry 999 ft. below land surface measured on mo/day/yr 9-29-93

Pump test data: Well water was ft. after hours pumping gpm

Est. Yield gpm: Well water was ft. after hours pumping gpm

Bore Hole Diameter in. to ft. and in. to ft.

WELL WATER TO BE USED AS: 5 Public water supply 8 Air conditioning 11 Injection well

① Domestic 3 Feedlot 6 Oil field water supply 9 Dewatering 12 Other (Specify below)

2 Irrigation 4 Industrial 7 Lawn and garden only 10 Monitoring well

Was a chemical/bacteriological sample submitted to Department? Yes No X; If yes, mo/day/yr sample was submittedWater Well Disinfected? Yes X No

5 TYPE OF BLANK CASING USED:

- ① Steel 3 RMP (SR)
2 PVC 4 ABS

- 5 Wrought iron 8 Concrete tile
6 Asbestos-Cement 9 Other (specify below)
7 Fiberglass

CASING JOINTS: Glued Clamped
Welded
Threaded

Blank casing diameter 5 1/2 in. to ft., Dia. in. to ft., Dia. in. to ft.Casing height above land surface 36 in., weight lbs./ft. Wall thickness or gauge No.

TYPE OF SCREEN OR PERFORATION MATERIAL:

- 1 Steel 3 Stainless steel
2 Brass 4 Galvanized steel

- 5 Fiberglass 8 RMP (SR)
6 Concrete tile 9 ABS

- 10 Asbestos-cement
11 Other (specify) NA
12 None used (open hole)

SCREEN OR PERFORATION OPENINGS ARE:

- 1 Continuous slot 3 Mill slot
2 Louvered shutter 4 Key punched

- 5 Gauzed wrapped 8 Saw cut 11 None (open hole)
6 Wire wrapped 9 Drilled holes
7 Torch cut 10 Other (specify) NA

SCREEN-PERFORATED INTERVALS: From NA ft. to NA ft., From ft. to ft.

From ft. to ft., From ft. to ft.

GRAVEL PACK INTERVALS: From ft. to ft., From ft. to ft.

From ft. to ft., From ft. to ft.

6 GROUT MATERIAL:

- 1 Neat cement ② Cement grout ③ Bentonite 4 Other

Grout Intervals: From 150 ft. to 145 ft., From 11 ft. to 8 ft., From 7 ft. to 0 ft.

What is the nearest source of possible contamination:

- 1 Septic tank 4 Lateral lines 7 Pit privy 11 Fuel storage 15 Oil well/Gas well
2 Sewer lines 5 Cess pool 8 Sewage lagoon 12 Fertilizer storage 16 Other (specify below)
3 Watertight sewer lines 6 Seepage pit 9 Feedyard 13 Insecticide storage

Direction from well?

How many feet?

FROM	TO	LITHOLOGIC LOG	FROM	TO	PLUGGING INTERVALS
			<u>150</u>	<u>145</u>	<u>Bentonite</u>
			<u>145</u>	<u>11</u>	<u>clay</u>
			<u>11</u>	<u>8</u>	<u>Bentonite</u>
			<u>8</u>	<u>7</u>	<u>clay</u>
			<u>7</u>	<u>0</u>	<u>Cement Grout</u>

7 CONTRACTOR'S OR LANDOWNER'S CERTIFICATION: This water well was (1) constructed, (2) reconstructed, or (3) plugged under my jurisdiction and was completed on (mo/day/year) 9-29-93 and this record is true to the best of my knowledge and belief. KansasWater Well Contractor's License No. This Water Well Record was completed on (mo/day/yr) 9-29-93under the business name of by (signature) Don Brown