

1] LOCATION OF WATER WELL: County: <u>Thomas</u>	Fraction <u>NE 1/4 SE 1/4 NW 1/4</u>	Section Number <u>28</u>	Township Number T <u>9</u> S	Range Number R <u>34</u> E <u>10</u>
---	---	-----------------------------	---------------------------------	---


Distance and direction from nearest town or city street address of well if located within city?

115 W of Colby

2] WATER WELL OWNER: RR#, St. Address, Box # : City, State, ZIP Code	<u>Rains &amp; Williams</u> <u>601 N. 1st St.</u> <u>KS</u>
--	---

Board of Agriculture, Division of Water Resources  
Application Number:

3] LOCATE WELL'S LOCATION WITH AN "X" IN SECTION BOX:
---

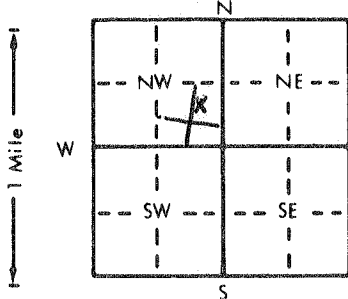

4] DEPTH OF COMPLETED WELL: <u>22.4</u> ft. ELEVATION:
Depth(s) Groundwater Encountered 1. <u>13.0</u> ft. 2. .... ft. 3. .... ft.
WELL'S STATIC WATER LEVEL <u>13.0</u> ft. below land surface measured on mo/day/yr
Pump test data: Well water was .... ft. after .... hours pumping .... gpm
Est. Yield <u>5.0</u> gpm: Well water was .... ft. after .... hours pumping .... gpm
Bore Hole Diameter <u>9</u> in. to <u>22.4</u> ft. and .... in. to .... ft.
WELL WATER TO BE USED AS:
5 Public water supply 8 Air conditioning 11 Injection well
1 Domestic 3 Feedlot <u>6</u> Oil field water supply 9 Dewatering 12 Other (Specify below)
2 Irrigation 4 Industrial 7 Lawn and garden only 10 Monitoring well
Was a chemical/bacteriological sample submitted to Department? Yes ..... No <u>X</u> If yes, mo/day/yr sample was submitted
Water Well Disinfected? Yes <u>X</u> No

5] TYPE OF BLANK CASING USED:	5 Wrought iron	8 Concrete tile	CASING JOINTS: Glued <u>X</u> Clamped
1 Steel	6 Asbestos-Cement	9 Other (specify below)	Welded
2 PVC	7 Fiberglass		Threaded
3 RMP (SR)			
4 ABS			
Blank casing diameter <u>5</u> in. to <u>22.4</u> ft. Dia			
Casing height above land surface <u>12</u> in. weight <u>250</u> lbs./ft. Wall thickness or gauge No. <u>250</u>			
TYPE OF SCREEN OR PERFORATION MATERIAL:			
1 Steel	5 Fiberglass	8 RMP (SR)	10 Asbestos-cement
2 Brass	6 Concrete tile	9 ABS	11 Other (specify)
3 Stainless steel			12 None used (open hole)
4 Galvanized steel			
SCREEN OR PERFORATION OPENINGS ARE:			
<u>6</u> Continuous slot	5 Gauzed wrapped	8 Saw cut	11 None (open hole)
2 Louvered shutter	6 Wire wrapped	9 Drilled holes	
4 Key punched	7 Torch cut	10 Other (specify)	
SCREEN-PERFORATED INTERVALS:			
From <u>21.4</u> ft. to <u>22.4</u> ft.			
GRAVEL PACK INTERVALS:			
From <u>13.0</u> ft. to <u>22.4</u> ft.			

6] GROUT MATERIAL:	1 Neat cement	2 Cement grout	3 Bentonite	4 Other
Grout Intervals: From <u>0</u> ft. to <u>2.0</u> ft.				
What is the nearest source of possible contamination:				
1 Septic tank	4 Lateral lines	7 Pit privy	10 Livestock pens	14 Abandoned water well
2 Sewer lines	5 Cess pool	8 Sewage lagoon	11 Fuel storage	15 Oil well/Gas well
3 Watertight sewer lines	6 Seepage pit	9 Feedyard	12 Fertilizer storage	16 Other (specify below)
			13 Insecticide storage	<u>Flatland</u>
Direction from well? <u>Flatland</u>			How many feet? <u>1</u>	

FROM	TO	LITHOLOGIC LOG	FROM	TO	PLUGGING INTERVALS
0	26	Topsoil			
26	49	M. Gravel			
49	61	Sandy Clay			
61	80	M. Gravel			
80	92	Gravel			
92	100	Sandy Clay			
100	128	Sandstone			
128	150	M. Gravel			
150	160	Sandy Clay			
160	182	Fine Sand			
182	220	Sandy Clay			
220	223	M. Gravel			
223	224	Clay			

7] CONTRACTOR'S OR LANDOWNER'S CERTIFICATION: This water well was <u>(1)</u> constructed, (2) reconstructed, or (3) plugged under my jurisdiction and was completed on (mo/day/year) <u>1-91</u> and this record is true to the best of my knowledge and belief. Kansas Water Well Contractor's License No. <u>376</u> This Water Well Record was completed on (mo/day/yr) <u>2-91</u> under the business name of <u>B &amp; B Drilling</u> by (signature) <u>Joseph Berkman</u>
--