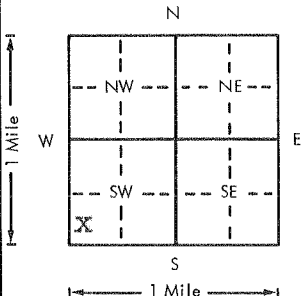


USE TYPEWRITER OR BALL POINT PEN-PRESS FIRMLY, PRINT CLEARLY.

WATER WELL RECORD
KSA 82a-1201-1215

Kansas Department of Health and Environment-Division of Environment
(Water well Contractors)
Topeka, Kansas 66620

CCC

1. Location of well:		County Thomas	Fraction SW 1/4 SW 1/4 SW 1/4	Section number 2	Township number T 9 S R 35 E/W	Range number 35
2. Distance and direction from nearest town or city: 5 Mi. S. of Levant I-70 interchange				3. Owner of well: M.L. Barrett R.R. or street: RT. 3 Box 116 City, state, zip code: Colby, Kansas 67701		
4. Locate with "X" in section below: 				Sketch map:		
5. Type and color of material				From	To	6. Bore hole dia. 8 in. Completion date 4/10/78 Well depth 207 ft.
Top Soil				0	42	7. <input checked="" type="checkbox"/> Cable tool <input checked="" type="checkbox"/> Rotary <input type="checkbox"/> Driven <input type="checkbox"/> Dug <input type="checkbox"/> Hollow rod <input type="checkbox"/> Jetted <input type="checkbox"/> Bored <input type="checkbox"/> Reverse rotary
Sandy clay				42	46	8. Use: <input checked="" type="checkbox"/> Domestic <input type="checkbox"/> Public supply <input type="checkbox"/> Industry <input type="checkbox"/> Irrigation <input type="checkbox"/> Air conditioning <input type="checkbox"/> Stock <input type="checkbox"/> Lawn <input type="checkbox"/> Oil field water <input type="checkbox"/> Other
Sand rock				46	48	9. Casing: Material plst Height: Above or below Threaded <input type="checkbox"/> Welded gl Surface 15 in. RMP <input checked="" type="checkbox"/> PVC Weight _____ lbs./ft. Dia. 5 in. to 207 ft. depth Wall Thickness: inches or Dia. _____ in. to _____ ft. depth gage No. 250
Sandy clay				48	55	10. Screen: Manufacturer's name _____ Type RMP Dia. 5" Slot/gauze .032 Length 20 Set between 187 ft. and 207 ft. _____ ft. and _____ ft. Gravel pack? yes range of material 1/8"
Sand and Sand Rock Strips				55	106	11. Static water level: _____ mo./day/yr. 171 ft. below land surface Date 4/10/78
Sand rock				106	112	12. Pumping level below land surfaces: _____ ft. after NA hrs. pumping _____ g.p.m. _____ ft. after _____ hrs. pumping _____ g.p.m. Estimated maximum yield _____ g.p.m.
Sand				112	119	13. Water sample submitted: _____ mo./day/yr. <input type="checkbox"/> Yes <input checked="" type="checkbox"/> No Date _____
Sand rock				119	127	14. Well head completion: yes Pitless adapter 20 Inches above grade
Sand and Sand rock strips				127	165	15. Well grouted? yes With: <input checked="" type="checkbox"/> Neat cement <input type="checkbox"/> Bentonite <input type="checkbox"/> Concrete Depth: From 4 ft. to 18 ft.
Sand rock hard Sand strips				165	182	16. Nearest source of possible contamination: ft. _____ Direction NA Type _____ Well disinfected upon completion? <input checked="" type="checkbox"/> Yes <input type="checkbox"/> No
Sand and Sand rock strips				182	201	17. Pump: _____ Not installed Manufacturer's name Red Jacket Model number _____ HP 2 Volts 230 Length of drop pipe _____ ft. capacity _____ g.p.m. Type: <input checked="" type="checkbox"/> Submersible _____ Turbine <input type="checkbox"/> Jet _____ Reciprocating <input type="checkbox"/> Centrifugal _____ Other
Sand				201	204	20. Water well contractor's certification: This well was drilled under my jurisdiction and this report is true to the best of my knowledge and belief. Bartell Drilling 139 Business name _____ License No. _____ Address Winona, Kansas 67764 Signed Joseph Bartell Date 8/30/78 Authorized representative
Oker and Shale				214	207	
BROCK 214						
(Use a second sheet if needed)						
18. Elevation:		19. Remarks:				
Topography: ____ Hill ____ Slope ____ Upland ____ Valley						

1-9
 35
 W
 1-20
 Sec
 1/4
 1/4
 1/4
 1/4

Forward the white, blue and pink copies to the Department of Health and Environment

Form WWC-5