


1 LOCATION OF WATER WELL: County: **SHERMAN** Fraction: **NE 1/4 NE 1/4 SW 1/4** Section Number: **9** Township Number: **T 9 S** Range Number: **R 37** **EW**

Distance and direction from nearest town or city street address of well if located within city?  
**From Edson 4 miles then 4 miles south.**

2 WATER WELL OWNER: **Brent Owens**  
 RR#, St. Address, Box # : **Rt. #1 Box 295** Board of Agriculture, Division of Water Resources  
 City, State, ZIP Code : **Edson, KS 67733** Application Number:

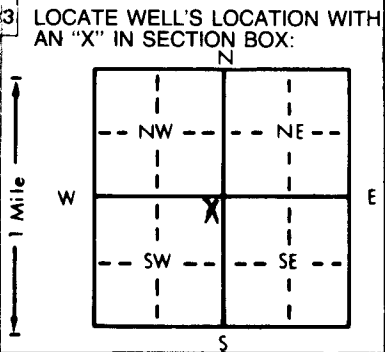

4 DEPTH OF COMPLETED WELL: **85'** ft. ELEVATION:  
 Depth(s) Groundwater Encountered 1. **58'** ft. 2. ft. 3. ft.  
 WELL'S STATIC WATER LEVEL **58'** ft. below land surface measured on mo/day/yr **2-27-92**  
 Pump test data: Well water was ft. after hours pumping gpm  
 Est. Yield gpm: Well water was ft. after hours pumping gpm  
 Bore Hole Diameter in. to ft., and in. to ft.  
 WELL WATER TO BE USED AS:  
 1 Domestic  2 Irrigation  3 Feedlot  4 Industrial  
 5 Public water supply  6 Oil field water supply  7 Lawn and garden only  
 8 Air conditioning  9 Dewatering  10 Monitoring well  
 11 Injection well  12 Other (Specify below)  
 Was a chemical/bacteriological sample submitted to Department? Yes..... No  ..... If yes, mo/day/yr sample was submitted  
 Water Well Disinfected?  Yes  No

5 TYPE OF BLANK CASING USED:  
 1 Steel  2 PVC  3 RMP (SR)  4 ABS  
 5 Wrought iron  6 Asbestos-Cement  7 Fiberglass  
 8 Concrete tile  9 Other (specify below)  
 Blank casing diameter **5"** in. to **65** ft. Dia. in. to ft. Dia. in. to ft. Dia. in. to ft.  
 Casing height above land surface **12** in., weight **200** lbs./ft. Wall thickness or gauge No. **SDR 21**  
 TYPE OF SCREEN OR PERFORATION MATERIAL:  
 1 Steel  2 Brass  3 Stainless steel  4 Galvanized steel  
 5 Fiberglass  6 Concrete tile  7 PVC  8 RMP (SR)  
 9 ABS  10 Asbestos-cement  11 Other (specify)  12 None used (open hole)  
 SCREEN OR PERFORATION OPENINGS ARE:  
 1 Continuous slot  2 Louvered shutter  3 Mill slot  4 Key punched  
 5 Gauzed wrapped  6 Wire wrapped  7 Torch cut  8 Saw cut  9 Drilled holes  10 Other (specify)  11 None (open hole)  
 SCREEN-PERFORATED INTERVALS: From **65** ft. to **85** ft., From ft. to ft.  
**8-12 Silica sand** From **35** ft. to **85** ft., From ft. to ft.  
 GRAVEL PACK INTERVALS: From ft. to ft., From ft. to ft.  
**Returns** From **20** ft. to **35** ft., From ft. to ft.

6 GROUT MATERIAL:  1 Neat cement  2 Cement grout  3 Bentonite  4 Other  
 Grout Intervals: From **0** ft. to **20** ft., From ft. to ft., From ft. to ft., From ft. to ft.  
 What is the nearest source of possible contamination:  
 1 Septic tank  2 Sewer lines  3 Watertight sewer lines  
 4 Lateral lines  5 Cess pool  6 Seepage pit  
 7 Pit privy  8 Sewage lagoon  9 Feedyard  
 10 Livestock pens  14 Abandoned water well  
 11 Fuel storage  12 Fertilizer storage  13 Insecticide storage  
 15 Oil well/Gas well  16 Other (specify below)

Direction from well? **South** How many feet? **50'**

FROM	TO	LITHOLOGIC LOG	FROM	TO	PLUGGING INTERVALS
0	40	Clay			
40	60	Sand			
60	80	Sand			
80	85	Shale			

7 CONTRACTOR'S OR LANDOWNER'S CERTIFICATION: This water well was  (1) constructed,  (2) reconstructed, or  (3) plugged under my jurisdiction and was completed on (mo/day/year) **2-27-92** and this record is true to the best of my knowledge and belief. Kansas Water Well Contractor's License No. **484** This Water Well Record was completed on (mo/day/yr) **3-5-92** under the business name of **Schaal Drilling, Co.** by (signature) *Ruben Schaal*