


1 LOCATION OF WATER WELL: Fraction NE 1/4 NE 1/4 SW 1/4 Section Number 9 Township Number T 9 S Range Number R 37 EW
 County: SHERMAN

Distance and direction from nearest town or city street address of well if located within city?
From Edson 4 miles then 4 miles south.

2 WATER WELL OWNER: Brent Owens
 RR#, St. Address, Box # #1 Box 295 Board of Agriculture, Division of Water Resources
 City, State, ZIP Code Edson, KS 67733 Application Number:

3 LOCATE WELL'S LOCATION WITH AN "X" IN SECTION BOX:

4 DEPTH OF COMPLETED WELL 61' ft. ELEVATION: _____

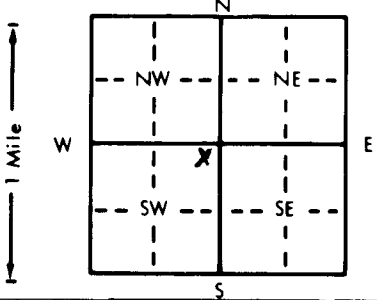

Depth(s) Groundwater Encountered 1 ft. 2. _____ ft. 3. _____ ft.
 WELL'S STATIC WATER LEVEL 999 ft. below land surface measured on mo/day/yr _____
 Pump test data: Well water was _____ ft. after _____ hours pumping _____ gpm
 Est. Yield _____ gpm: Well water was _____ ft. after _____ hours pumping _____ gpm
 Bore Hole Diameter _____ in. to _____ ft., and _____ in. to _____ ft.
 WELL WATER TO BE USED AS: 5 Public water supply 8 Air conditioning 11 Injection well
1 Domestic 3 Feedlot 6 Oil field water supply 9 Dewatering 12 Other (Specify below)
 2 Irrigation 4 Industrial 7 Lawn and garden only 10 Monitoring well _____
 Was a chemical/bacteriological sample submitted to Department? Yes _____ No X _____; If yes, mo/day/yr sample was sub-
 mitted _____ Water Well Disinfected? Yes X No _____

5 TYPE OF BLANK CASING USED: 5 Wrought iron 8 Concrete tile CASING JOINTS: Glued _____ Clamped _____
1 Steel galv. 3 RMP (SR) 6 Asbestos-Cement 9 Other (specify below) Welded _____
 2 PVC 4 ABS 7 Fiberglass _____ Threaded _____

Blank casing diameter 5 in. to _____ ft., Dia _____ in. to _____ ft., Dia _____ in. to _____ ft.
 Casing height above land surface 90 in., weight _____ lbs./ft. Wall thickness or gauge No. _____

TYPE OF SCREEN OR PERFORATION MATERIAL: 7 PVC 10 Asbestos-cement
 1 Steel 3 Stainless steel 5 Fiberglass 8 RMP (SR) 11 Other (specify) N/A
 2 Brass 4 Galvanized steel 6 Concrete tile 9 ABS 12 None used (open hole)

SCREEN OR PERFORATION OPENINGS ARE: 5 Gauzed wrapped 8 Saw cut 11 None (open hole)
 1 Continuous slot 3 Mill slot 6 Wire wrapped 9 Drilled holes
 2 Louvered shutter 4 Key punched 7 Torch cut 10 Other (specify) N/A

SCREEN-PERFORATED INTERVALS: From N/A ft. to N/A ft., From _____ ft. to _____ ft.
 From _____ ft. to _____ ft., From _____ ft. to _____ ft.
 GRAVEL PACK INTERVALS: From _____ ft. to _____ ft., From _____ ft. to _____ ft.
 From _____ ft. to _____ ft., From _____ ft. to _____ ft.

6 GROUT MATERIAL: 1 Neat cement 2 Cement grout 3 Bentonite 4 Other _____
 Grout Intervals: From 9 ft. to 8 ft., From _____ ft. to _____ ft., From _____ ft. to _____ ft.

What is the nearest source of possible contamination:
 1 Septic tank 4 Lateral lines 7 Pit privy 10 Livestock pens 14 Abandoned water well
 2 Sewer lines 5 Cess pool 8 Sewage lagoon 11 Fuel storage 15 Oil well/Gas well
 3 Watertight sewer lines 6 Seepage pit 9 Feedyard 12 Fertilizer storage 16 Other (specify below) NONE
 13 Insecticide storage _____

Direction from well? _____ How many feet? _____

FROM	TO	LITHOLOGIC LOG	FROM	TO	PLUGGING INTERVALS
			0	8	Rip off casing with backhoe
			8	61	backfill with clay
					Old well plugged back with local surface materials.
					Cement cap on casing.

7 CONTRACTOR'S OR LANDOWNER'S CERTIFICATION: This water well was (1) constructed, (2) reconstructed, or (3) plugged under my jurisdiction and was completed on (mo/day/year) 2-27-92 and this record is true to the best of my knowledge and belief. Kansas Water Well Contractor's License No. 484 This Water Well Record was completed on (mo/day/year) 3-5-92 under the business name of Schaal Drilling, Co. by (signature) Rubus Schaal