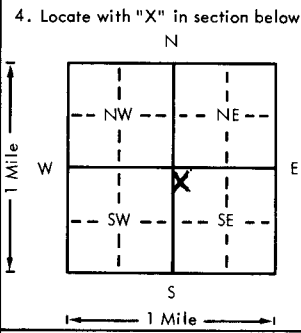


USE TYPEWRITER OR BALL POINT PEN—PRESS FIRMLY, PRINT CLEARLY.

WATER WELL RECORD  
KSA 82a-1201-1215

Kansas Department of Health and Environment—Division of Environment  
(Water well Contractors)  
Topeka, Kansas 66620

DBB

1. Location of well: County <u>SHERMAN</u> Fraction <u>NW<sup>1</sup>/<sub>4</sub> NW<sup>1</sup>/<sub>4</sub> SE<sup>1</sup>/<sub>4</sub></u> Section number <u>31</u> Township number <u>T 9 S R 37</u> Range number <u>NW</u>	
2. Distance and direction from nearest town or city: <u>Edson</u> Street address of well location if in city: <u>2 E 7<sup>1</sup>/<sub>2</sub> S 1<sup>1</sup>/<sub>2</sub> E</u>	
3. Owner of well: <u>MUELLER FARMS</u> R.R. or street: City, state, zip code: <u>BIRD CITY KANSAS 67731</u>	
4. Locate with "X" in section below: Sketch map: 	
6. Bore hole dia. <u>8</u> in. Completion date <u>10-12-78</u> Well depth <u>134</u> ft.	
7. <input checked="" type="checkbox"/> Cable tool <input checked="" type="checkbox"/> Rotary <input type="checkbox"/> Driven <input type="checkbox"/> Dug <input type="checkbox"/> Hollow rod <input type="checkbox"/> Jetted <input type="checkbox"/> Bored <input type="checkbox"/> Reverse rotary	
8. Use: <input checked="" type="checkbox"/> Domestic <input type="checkbox"/> Public supply <input type="checkbox"/> Industry <input type="checkbox"/> Irrigation <input type="checkbox"/> Air conditioning <input type="checkbox"/> Stock <input type="checkbox"/> Lawn <input type="checkbox"/> Oil field water <input type="checkbox"/> Other	
9. Casing: Material <u>Plastic</u> Height: <u>Above</u> or below Threaded <input type="checkbox"/> Welded <input checked="" type="checkbox"/> Surface <u>60</u> in. RMP <input type="checkbox"/> PVC <input checked="" type="checkbox"/> Weight <u>18</u> lbs./ft. Dia. <u>4</u> in. to <u>226</u> ft. depth Wall Thickness: inches or Dia. <u>4</u> in. to <u>226</u> ft. depth gauge No. <u>1237</u>	
5. Type and color of material	
	From To
<u>Top Soil</u>	<u>0 4</u>
<u>SANDY CLAY</u>	<u>4 16</u>
<u>M GRAVEL</u>	<u>16 32</u>
<u>M GRAVEL, CLAY</u>	<u>32 60</u>
<u>M GRAVEL</u>	<u>60 63</u>
<u>Clay</u>	<u>63 70</u>
<u>M GRAVEL</u>	<u>70 78</u>
<u>SANDY CLAY</u>	<u>78 95</u>
<u>M GRAVEL</u>	<u>95 108</u>
<u>Clay</u>	<u>108 116</u>
<u>M GRAVEL, SANDSTONE</u>	<u>116 124</u>
<u>Shale</u>	<u>124 134</u>
	<u>BROCK 124'</u>
(Use a second sheet if needed)	
10. Screen: Manufacturer's name <u>Peerless</u> Type <u>Louyer</u> Dia. <u>5"</u> Slot/gauze <u>18-250</u> Length <u>8'</u> Set between <u>126</u> ft. and <u>134</u> ft. Gravel pack? <u>Yes</u> Size range of material <u>1/8</u>	
11. Static water level: <u>114</u> ft. below land surface Date <u>8-31-78</u> mo./day/yr.	
12. Pumping level below land surfaces: <u>130</u> ft. after <u>5</u> hrs. pumping <u>5</u> g.p.m. Estimated maximum yield <u>5</u> g.p.m.	
13. Water sample submitted: <u>Yes</u> <input checked="" type="checkbox"/> No <input type="checkbox"/> Date	
14. Well head completion: <input checked="" type="checkbox"/> Pitless adapter <u>12</u> Inches above grade	
15. Well grouted? <u>Yes</u> With: <input checked="" type="checkbox"/> Neat cement <input type="checkbox"/> Bentonite <input type="checkbox"/> Concrete Depth: From <u>5</u> ft. to <u>15</u> ft.	
16. Nearest source of possible contamination: ft. Direction Type <u>PSURC</u> Well disinfected upon completion? <input checked="" type="checkbox"/> Yes <input type="checkbox"/> No	
17. Pump: Not installed Manufacturer's name <u>Red Jacket</u> Model number <u>13AD</u> HP <u>1/2</u> Volts <u>230</u> Length of drop pipe <u>130</u> ft. capacity <u>5</u> g.p.m. Type: <input checked="" type="checkbox"/> Submersible <input type="checkbox"/> Turbine <input type="checkbox"/> Jet <input type="checkbox"/> Reciprocating <input type="checkbox"/> Centrifugal <input type="checkbox"/> Other	
18. Elevation: Topography: <input type="checkbox"/> Hill <input checked="" type="checkbox"/> Slope <input checked="" type="checkbox"/> Upland <input type="checkbox"/> Valley	19. Remarks:
20. Water well contractor's certification: This well was drilled under my jurisdiction and this report is true to the best of my knowledge and belief. <u>Stet Dylling Co. Inc. 166</u> Business name License No. Address <u>Woodland Kan</u> Signed <u>Bell Clifford</u> Date <u>10-13-78</u> Authorized representative	

T 9 37 W 31 NW NW SE 1/4 1/4 1/4