


WATER WELL RECORD Form WW-5 KSA 82a-1212

1 LOCATION OF WATER WELL: County: Sherman Fraction SE SE SE Section Number 11 Township Number T 9 S Range Number R 38 E/W

Distance and direction from nearest town or city street address of well if located within city?
Confirmed by GMD 4

2 WATER WELL OWNER: Federal Land Bank of Wichita. Board of Agriculture, Division of Water Resources
 RR#, St. Address, Box #: P.O. Box 2940 Application Number:
 City, State, ZIP Code: Wichita, KS 67201-2940

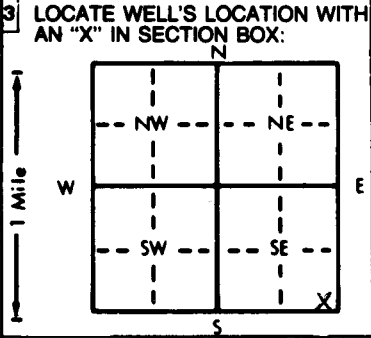

4 DEPTH OF COMPLETED WELL: 120' ft. ELEVATION:
 Depth(s) Groundwater Encountered 1. ft. 2. ft. 3. ft.
 WELL'S STATIC WATER LEVEL 110' ft. below land surface measured on mo/day/yr 4-12-90
 Pump test data: Well water was ft. after hours pumping gpm
 Est. Yield gpm; Well water was ft. after hours pumping gpm
 Bore Hole Diameter in. to ft., and in. to ft.
 WELL WATER TO BE USED AS: 5 Public water supply 8 Air conditioning 11 Injection well
 1 Domestic 3 Feedlot 6 Oil field water supply 9 Dewatering 12 Other (Specify below)
 2 Irrigation 4 Industrial 7 Lawn and garden only 10 Monitoring well
 Was a chemical/bacteriological sample submitted to Department? Yes.....No.....; If yes, mo/day/yr sample was submitted
 Water Well Disinfected? Yes No

5 TYPE OF BLANK CASING USED: 1 Steel 3 RMP (SR) 5 Wrought iron 8 Concrete tile CASING JOINTS: Glued Clamped
 2 PVC 4 ABS 7 Fiberglass Welded
 Blank casing diameter 6 in. to ft., Dia. in. to ft., Dia. in. to ft.
 Casing height above land surface 4' Below in., weight lbs./ft. Wall thickness or gauge No.
 TYPE OF SCREEN OR PERFORATION MATERIAL: 7 PVC 10 Asbestos-cement
 1 Steel 3 Stainless steel 5 Fiberglass 8 RMP (SR) 11 Other (specify)
 2 Brass 4 Galvanized steel 6 Concrete tile 9 ABS 12 None used (open hole)
 SCREEN OR PERFORATION OPENINGS ARE: 5 Gauzed wrapped 8 Saw cut 11 None (open hole)
 1 Continuous slot 3 Mill slot 6 Wire wrapped 9 Drilled holes
 2 Louvered shutter 4 Key punched 7 Torch cut 10 Other (specify)

6 GROUT MATERIAL: 1 Neat cement 2 Cement grout 3 Bentonite 4 Other
 Grout Intervals: From 12 ft. to 7 ft., From 7 ft. to 4 ft., From ft. to ft.
 What is the nearest source of possible contamination: Bentonite Cement Ceruit
 1 Septic tank 4 Lateral lines 7 Pit privy 11 Fuel storage 14 Abandoned water well
 2 Sewer lines 5 Cess pool 8 Sewage lagoon 12 Fertilizer storage 15 Oil well/Gas well
 3 Watertight sewer lines 6 Seepage pit 9 Feedyard 13 Insecticide storage 16 Other (specify below)
 Direction from well? None, Abandoned Farm
 How many feet? 7

FROM	TO	LITHOLOGIC LOG	FROM	TO	PLUGGING INTERVALS
			120'	100	washed sand
			100	12	Clay
			12	7	Bentonite
			7	4	Cement Ceruit
			4	0	Compacted Clay + Topsoil

RECEIVED
 APR 30 1990
 DIVISION OF ENVIRONMENT

7 CONTRACTOR'S OR LANDOWNER'S CERTIFICATION: This water well was (1) constructed, (2) reconstructed, or plugged under my jurisdiction and was completed on (mo/day/year) 4-20-90 and this record is true to the best of my knowledge and belief. Kansas Water Well Contractor's License No. This Water Well Record was completed on (mo/day/yr) 4-23-90 under the business name of by (signature) [Signature]

OFFICE USE ONLY
 T
 R
 EW
 SEC.