


1 LOCATION OF WATER WELL: County: **SHERMAN** Fraction: **NW 1/4 NW 1/4 NW 1/4** Section Number: **16** Township Number: **T 9 S** Range Number: **R 39 EW**

Distance and direction from nearest town or city street address of well if located within city?
4 South, 2 East Goodland KS.

2 WATER WELL OWNER: **Dat House**
 RR#, St. Address, Box #: **5995 Rd 21**
 City, State, ZIP Code: **Goodland KS 67735**
 Board of Agriculture, Division of Water Resources
 Application Number:

3 LOCATE WELL'S LOCATION WITH AN "X" IN SECTION BOX:

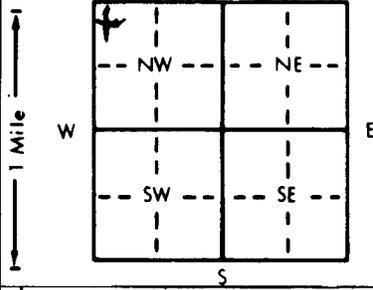

4 DEPTH OF COMPLETED WELL: **235** ft. ELEVATION:

Depth(s) Groundwater Encountered 1. **155** ft. 2. . ft. 3. . ft.
 WELL'S STATIC WATER LEVEL . . . **155** ft. below land surface measured on mo/day/yr . . .
 Pump test data: Well water was . . . ft. after . . . hours pumping . . . gpm
 Est. Yield . . . gpm: Well water was . . . ft. after . . . hours pumping . . . gpm
 Bore Hole Diameter: **8** in. to **235** ft., and . . . in. to . . . ft.
 WELL WATER TO BE USED AS:
 1 Domestic 2 Irrigation 3 Feedlot 4 Industrial
 5 Public water supply 6 Oil field water supply 7 Lawn and garden only
 8 Air conditioning 9 Dewatering 10 Monitoring well
 11 Injection well 12 Other (Specify below)
 Was a chemical/bacteriological sample submitted to Department? Yes . . . No . . . If yes, mo/day/yr sample was submitted
 Water Well Disinfected? Yes No

5 TYPE OF BLANK CASING USED:
 Steel 3 RMP (SR) 6 Asbestos-Cement 9 Other (specify below)
 2 PVC 4 ABS 7 Fiberglass 8 Concrete tile
 CASING JOINTS: Glued Clamped Welded Threaded

Blank casing diameter . . . **4.5** in. to **195** ft., Dia **6 7/8 SURFACE** in. to **20'** ft., Dia . . . in. to . . . ft.
 Casing height above land surface . . . **12** in., weight **160** lbs./ft. Wall thickness or gauge No. **SDR 26**

TYPE OF SCREEN OR PERFORATION MATERIAL:
 1 Steel 3 Stainless steel 5 Fiberglass 8 RMP (SR) 10 Asbestos-cement
 2 Brass 4 Galvanized steel 6 Concrete tile 9 ABS 11 Other (specify) . . .
 12 None used (open hole)

SCREEN OR PERFORATION OPENINGS ARE:
 1 Continuous slot 3 Mill slot 5 Gauzed wrapped 8 Saw cut 11 None (open hole)
 2 Louvered shutter 4 Key punched 6 Wire wrapped 9 Drilled holes
 7 Torch cut 10 Other (specify) . . .

SCREEN-PERFORATED INTERVALS: From . . . **195** ft. to **235** ft., From . . . ft. to . . . ft.
8-12 Silica Sand From . . . ft. to . . . ft., From . . . ft. to . . . ft.
 GRAVEL PACK INTERVALS: From . . . **155** ft. to **235** ft., From . . . ft. to . . . ft.
Returns From **20** ft. to **155** ft., From . . . ft. to . . . ft.

6 GROUT MATERIAL: 1 Neat cement 2 Cement grout 3 Bentonite 4 Other . . .
 Grout Intervals: From . . . **0** ft. to **20** ft., From . . . ft. to . . . ft., From . . . ft. to . . . ft.

What is the nearest source of possible contamination:
 1 Septic tank 4 Lateral lines 7 Pit privy 10 Livestock pens 14 Abandoned water well
 2 Sewer lines 5 Cess pool 8 Sewage lagoon 11 Fuel storage 15 Oil well/Gas well
 3 Watertight sewer lines 6 Seepage pit 9 Feedyard 12 Fertilizer storage 16 Other (specify below)
 13 Insecticide storage

Direction from well? **NONE IN VIEW** How many feet?

FROM	TO	LITHOLOGIC LOG	FROM	TO	PLUGGING INTERVALS
0	60	Clay			
60	120	Sand			
120	200	Sandstone - sand - layered clay			
200	210	Sandstone			
210	225	Clay			
225	235	gravel			

7 CONTRACTOR'S OR LANDOWNER'S CERTIFICATION: This water well was (1) constructed, (2) reconstructed, or (3) plugged under my jurisdiction and was completed on (mo/day/year) . . . **8-28-95** . . . and this record is true to the best of my knowledge and belief. Kansas Water Well Contractor's License No. **484** This Water Well Record was completed on (mo/day/yr) **8-27-95** under the business name of **Schaal Drilling, Co.** by (signature) **[Signature]**