

USE TYPEWRITER OR BALL POINT PEN-PRESS FIRMLY, PRINT CLEARLY.

GOODLAND

T R EW sec 1/4 1/4 1/4 No.

WATER WELL RECORD
KSA 82a-1201-1215

Kansas State Dept. Of Health
(Water Well Contractors)
Forbes-Bldg. 740
Topeka, Kansas 66620

BAC


1 Location of well:	County Sherman ;	Township name Itasco	Section number 4	Town number 9 W S	Range number 39 W
---------------------	----------------------------	--------------------------------	----------------------------	-----------------------------	-----------------------------

Distance and direction from nearest town or city: **4 S of Goodland**

Street address of well location if in city: _____

3 Owner of well: **Lawrence House**

Address: **Goodland, Kansas
Route 2 Box 100**

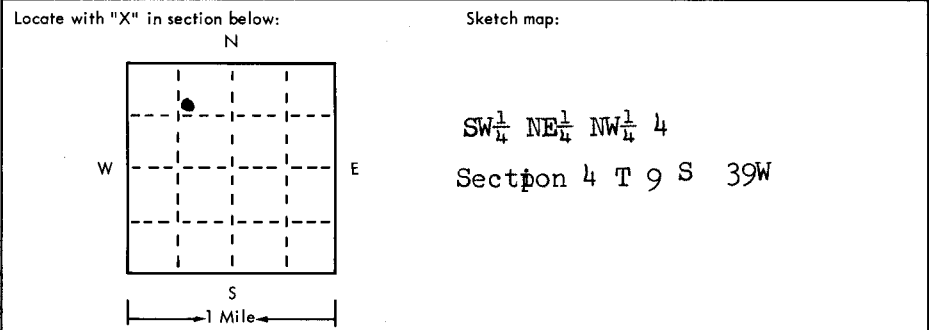

4 Well depth: 280 ft. Date of completion 2-75
Well diameter 30 in.

5 Cable tool Rotary Driven Dug
 Hollow rod Jetted Bored Reverse rotary

6 Use: Domestic Public supply Industry
 Irrigation Air conditioning Commercial
 Test well

7 Casing: Material steel Height: above/below
Threaded Welded Surface 12 in.
Diam. 16 in. to 280 ft. depth Weight 36 lbs./ft.
Drive shoe? Yes No
 in. to ft. depth

2 Type and color of material	From	To
sand and clay	0	131
medium to good sand	131	138
clay and rock	138	183
medium to good sand loose clean	183	189
clay	189	203
good medium to good sand loose clean	203	208
XX		
very hard hard rock	208	225
medium sand loose clean	225	230
hard rock	230	232
medium to good sand tight	232	240
hard rock	240	251
good fine to medium sand loose clean	251	270
good fine to medium sand very clean	270	278
blue	278	280
(use a second sheet if needed)		

8 Screen: **none**
Manufacturer: **Sargent Irrigation**
Type steel Dia. 16"
Slot gauze 2" Length 60
Set between 220 ft. and 280 ft.
Fittings:
Gravel pack Yes No Size range of material 3/16

9 Static water level:
117 ft. below land surface Date 2-75 2-12-75

10 Pumping level below land surfaces:
138 ft. after 70 hrs. pumping 800 g.p.m.
 ft. after hrs. pumping g.p.m.
Estimated maximum yield 1000 g.p.m.

11 Water sample submitted:
 Yes No Date _____

12 Well head completion:
 Pitless adapter Inches above grade 12"

13 Well grouted? Yes No
 Neat cement Bentonite _____
Depth: From 0 ft. to 1 ft.

14 Nearest source of possible contamination: **none**
ft. Direction _____ Type _____
Well disinfected upon completion? Yes No

15 Pump: Not installed
Manufacturer's name **BJ Byron Jackson**
Model number **Turbine** 82 Volts _____
Length of drop pipe 270 ft. capacity 800 g.p.m.
Type:
 Submersible Turbine
 Jet Reciprocating
 Centrifugal Other

16 Remarks: elevation 3670 (TOTO)

Topography:
 Hill
 Slope
 Upland
 Valley

17 Water well contractor's certification:
This well was drilled under my jurisdiction and this report is true to the best of my knowledge and belief.
Northwest Drilling Co. 248
Business name License No. _____
Address **Scott City, Kans.**
Signed Ben Hays Date 4-75
Authorized representative Date 4-30-75