

USE TYPEWRITER OR BALL POINT PEN—PRESS FIRMLY, PRINT CLEARLY.

T R EW sec 1/4 1/4 1/4 No.

WATER WELL RECORD
KSA 82a-1201-1215

Kansas State Dept. Of Health
(Water Well Contractors)
Forbes-Bldg. 740
Topeka, Kansas 66620


BBB

1 Location of well:	County Sherman	Township name Itasco	Section number 11	Town number 9 S	Range number 39 W
---------------------	--------------------------	--------------------------------	-----------------------------	---------------------------	-----------------------------

Distance and direction from nearest town or city: **4 miles E $4\frac{1}{2}$ S**
of Goodland, Kansas

Street address of well location if in city: _____

3 Owner of well: **Harlan House**
Address: **Route 2 Goodland, Kansas**

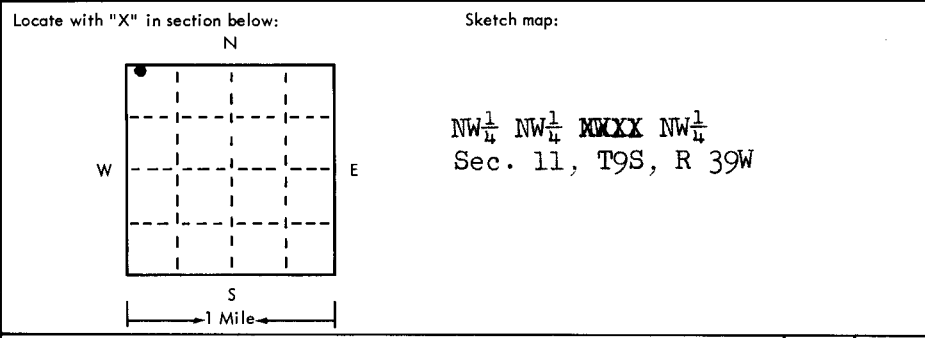

4 Well depth: 270 ft. Date of completion: 8-74
Well diameter 30 in. 8-29-74

5 Cable tool Rotary Driven Dug
 Hollow rod Jetted Bored Reverse rotary

6 Use: Domestic Public supply Industry
 Irrigation Air conditioning Commercial
 Test well

7 Casing: Material steel Height: 36 ft. below
Threaded Welded Surface 36 in.
Diam. _____ Weight 36 lbs./ft. _____
16 in. to 270 ft. depth Drive shoe? Yes No
_____ in. to _____ ft. depth!

2	Type and color of material	From	To
	Clay gravel and rock	0	152
	medium to good loose clean	162	163
	clay and rock	163	182
	X medium sand loose clean	182	186
	clay and rock	186	199
	X sand fine to coarse very loose clean	199	236
	clay rock and sand streaks	236	258
	fine sand loose clean	258	265
	soapstone	265	270

8 Screen: none
Manufacturer Sargent Irrigation
Type steel Dia. 16"
slow gauze 2" Length 60
Set between 210 ft. and 270 ft. _____
Fittings:
Gravel pack Yes No Size range of material 3/16

9 Static water level:
114 ft. below land surface Date 8-74 8-30-74

10 Pumping level below land surfaces:
160 ft. after 70 hrs. pumping 800 g.p.m.
_____ ft. after _____ hrs. pumping _____ g.p.m.
Estimated maximum yield 1000 g.p.m.

11 Water sample submitted:
 Yes No Date _____

12 Well head completion:
 Pitless adapter Inches above grade 12"

13 Well grouted? Yes No
 Neat cement Bentonite _____
Depth: From 0 ft. to 1 ft.

14 Nearest source of possible contamination: none
ft. _____ Direction _____ Type _____
Well disinfected upon completion? Yes No

15 Pump: Not installed
Manufacturer's name B.J. Byron Jackson
Model number turbine HP 100 Volts _____
Length of drop pipe 260 ft. capacity 800 g.m.p.
Type:
 Submersible Turbine
 Jet Reciprocating
 Centrifugal Other

16 Remarks: elevation

3651 (7000)

Topography:
 Hill
 Slope
 Upland
 Valley

17 Water well contractor's certification:
This well was drilled under my jurisdiction and this report is true to the best of my knowledge and belief.

Northwest Drilling Co. 248
Business name License No. _____
Address Scott City, Kans.
Signed Ben Kelly Date 4-74
Authorized representative 4-30-74