


USE TYPEWRITER OR BALL POINT PEN-PRESS FIRMLY, PRINT CLEARLY.

WATER WELL RECORD  
KSA 82a-1201-1215

Kansas Department of Health and Environment-Division of Environment (Water well Contractors) Topeka, Kansas 66620

1. Location of well: County Sherman Federation 1/4 Sec 15 1/4 E 1/4 Section number 15 Township number T 9 S Range number R 39 E 10

2. Distance and direction from nearest town or city: Street address of well location if in city: 3. Owner of well: Leo Hatcher R.R. or street: R.R. 1 City, state, zip code: Goodland Kansas

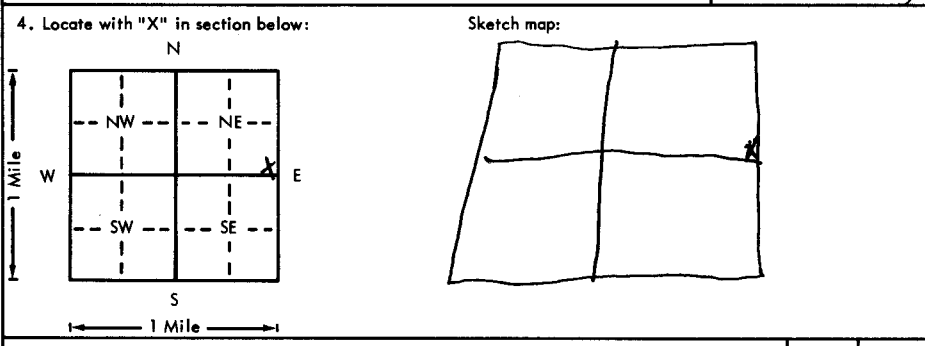

6. Bore hole dia. 24 in. Completion date 3-15-77 Well depth 262 ft.

7. Cable tool  Rotary  Driven  Dug  Hollow rod  Jetted  Bored  Reverse rotary

8. Use: Domestic  Public supply  Industry  Irrigation  Air conditioning  Stock  Lawn  Oil field water  Other

9. Casing: Material Steel Height: Above or below Threaded  Welded  Surface 8 in. RMP  PVC  Weight 27 lbs./ft. Dia. 8 in. to 42 ft. depth Wall Thickness: inches or Dia. 188 in. to     ft. depth Gauge No. 188

5. Type and color of material	From	To
Clay Sandstone & Gravel	0	131
Gravel	131	140
Sandstone & Clay	140	155
Gravel	155	158
Clay Sandstone & Sandy clay	158	214
Gravel	214	216
Clay	216	224
Gravel	224	231
Sandstone	231	236
Gravel	236	251
Soapstone	251	262
Shale	262	268

10. Screen: Manufacturer's name N. A. BROWN

Type Millsoft Dia. 16 Slot/gauze 1/8 Length 120 ft. Set between 142 ft. and 262 ft. Gravel pack?  Size range of material 1/2 in.

11. Static water level: 131 ft. below land surface Date 3-18-77 mo./day/yr.

12. Pumping level below land surfaces: 160 ft. after 6 hrs. pumping 400 g.p.m. 250 ft. after 10 hrs. pumping 535 g.p.m. Estimated maximum yield 535 g.p.m.


13. Water sample submitted: Yes  No  Date     mo./day/yr.

14. Well head completion: None Pitless adapter     inches above grade

15. Well grouted?  With: Neat cement  Bentonite  Concrete Depth: From 8' 46" to 10 ft. below

16. Nearest source of possible contamination: None ft. None direction None Type None Well disinfected upon completion? Yes  No

17. Pump: Not installed Manufacturer's name JOHNSTON PUMP Model number 98815 HP 110 Volts     Length of drop pipe 250 ft. capacity 535 g.p.m. Type:  Submersible  Turbine  Jet  Reciprocating  Centrifugal  Other

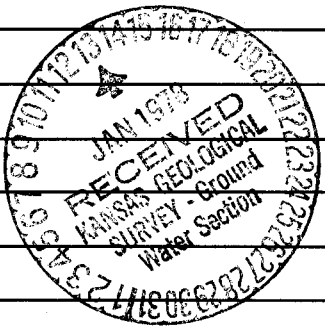

18. Elevation: Topography:  Hill  Slope  Upland  Valley 19. Remarks: 3640 (TOPO) Concrete Run By Foust Supply Co Inc.

20. Water well contractor's certification: This well was drilled under my jurisdiction and this report is true to the best of my knowledge and belief. Foust Supply Co Inc 144 Business name License No. Address Box 338 Goodland Signed Paul Chman Date 3-6-77 Authorized representative

YMC  
 T-9  
 R-39  
 E-15  
 SE-SE  
 NE-NE  
 Sec 15 1/4 E 1/4