


USE TYPEWRITER OR BALL POINT PEN-PRESS FIRMLY, PRINT CLEARLY.

AAC  
SW/4 NE/4 NE/4

WATER WELL RECORD  
KSA 82a-1201-1215

Kansas Department of Health and Environment-Division of Environment  
(Water well Contractors)  
Topeka, Kansas 66620

1. Location of well:		County <u>Sherman</u>	Fraction <u>SW/4 NE/4 NE/4</u>	Section number <u>21</u>	Township number <u>T 9</u>	Range number <u>S R 39</u>	<u>E 10</u>
2. Distance and direction from nearest town or city: <u>4600TH 3 EAST 1/2 SOUTHWEST</u>				Owner of well: <u>Leo Hatcher</u>			
Street address of well location if in city: <u>OF GOODLAND, KANSAS</u>				R.R. or street: <u>R.R. 1</u>			
				City, state, zip code: <u>Goodland Kansas</u>			
4. Locate with "X" in section below:		Sketch map:		6. Bore hole dia. <u>24</u> in. Completion date <u>3-7-77</u> Well depth <u>262</u> ft.			
				7. Cable tool <input type="checkbox"/> Rotary <input type="checkbox"/> Driven <input type="checkbox"/> Dug <input type="checkbox"/> Hollow rod <input type="checkbox"/> Jetted <input type="checkbox"/> Bored <input checked="" type="checkbox"/> Reverse rotary			
5. Type and color of material		From	To	8. Use: Domestic <input type="checkbox"/> Public supply <input type="checkbox"/> Industry <input type="checkbox"/> <input checked="" type="checkbox"/> Irrigation <input type="checkbox"/> Air conditioning <input type="checkbox"/> Stock <input type="checkbox"/> Lawn <input type="checkbox"/> Oil field water <input type="checkbox"/> Other <input type="checkbox"/>			
<u>Clay Gravel &amp; Sandstone</u>		<u>0</u>	<u>133</u>	9. Casing: Material <u>Steel</u> Height: <u>Above</u> or below Threaded <input type="checkbox"/> Welded <input checked="" type="checkbox"/> Surface <u>8</u> in. RMP <input type="checkbox"/> PVC <input type="checkbox"/> Weight <u>27</u> lbs./ft. Dia. <u>8</u> in. to <u>142</u> ft. depth Wall Thickness: inches or Dia. <input type="checkbox"/> in. to <input type="checkbox"/> ft. depth Gage No. <u>188</u>			
<u>Gravel</u>		<u>133</u>	<u>134</u>	10. Screen: Manufacturer's name <u>W.A. BROWN</u> Type <u>Mill Silt</u> Dia. <u>16</u> Slot/gauze <u>1/8</u> Length <u>40</u> <u>120'</u> <u>WMC</u> Set between <u>142</u> ft. and <u>262</u> ft. ft. and <input type="checkbox"/> ft. Gravel pack? <input checked="" type="checkbox"/> Size range of material <u>1/2</u>			
<u>Clay</u>		<u>134</u>	<u>136</u>	11. Static water level: <input type="checkbox"/> mo./day/yr. <u>133</u> ft. below land surface Date <u>3-11-77</u>			
<u>Gravel</u>		<u>136</u>	<u>140</u>	12. Pumping level below land surfaces: <u>151</u> ft. after <u>4</u> hrs. pumping <u>500</u> g.p.m. <u>240</u> ft. after <u>16</u> hrs. pumping <u>636</u> g.p.m. Estimated maximum yield <u>636</u> g.p.m.			
<u>Sandy clay Sandstone &amp; Gravel</u>		<u>140</u>	<u>216</u>	13. Water sample submitted: <input type="checkbox"/> mo./day/yr. Yes <input checked="" type="checkbox"/> No <input type="checkbox"/> Date <input type="checkbox"/>			
<u>Gravel</u>		<u>216</u>	<u>220</u>	14. Well head completion: <u>None</u> <input type="checkbox"/> Pitless adapter <input type="checkbox"/> inches above grade			
<u>Clay</u>		<u>220</u>	<u>222</u>	15. Well grouted? <input checked="" type="checkbox"/> With: <input type="checkbox"/> Neat cement <input checked="" type="checkbox"/> Bentonite <input type="checkbox"/> Concrete Depth: From <u>8" Above</u> to <u>10</u> ft. below			
<u>Gravel</u>		<u>222</u>	<u>252</u>	16. Nearest source of possible contamination: ft. <u>None</u> Direction <u>N 20° W</u> Type <u>None</u> Well disinfected upon completion? <input checked="" type="checkbox"/> Yes <input type="checkbox"/> No <input type="checkbox"/>			
<u>Soapstone</u>		<u>252</u>	<u>261</u>	17. Pump: <input type="checkbox"/> Not installed Manufacturer's name <u>JOHNSTON PUMP</u> Model number <u>20814</u> HP <u>112</u> Volts <input type="checkbox"/> Length of drop pipe <u>250</u> ft. capacity <u>636</u> g.p.m. Type: <input type="checkbox"/> Submersible <input checked="" type="checkbox"/> Turbine <input type="checkbox"/> Jet <input type="checkbox"/> Reciprocating <input type="checkbox"/> Centrifugal <input type="checkbox"/> Other			
<u>Shale</u>		<u>261</u>	<u>271</u>	20. Water well contractor's certification: This well was drilled under my jurisdiction and this report is true to the best of my knowledge and belief. <u>JOHNSTON PUMP CO INC</u> <u>144</u> Business name License No. Address <u>Box 338 Goodland</u> Signed <u>Ralph Johnson</u> Date <u>5-5-77</u> Authorized representative			
18. Elevation:		19. Remarks:					
Topography: <input type="checkbox"/> Hill <input type="checkbox"/> Slope <input type="checkbox"/> Upland <input type="checkbox"/> Valley		<u>3670 (TOD)</u> <u>Concrete was run</u> <u>By Foust Supply Co.</u>					

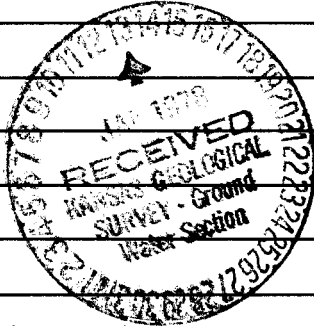

T 9 R 39 E 10 SW NE NE