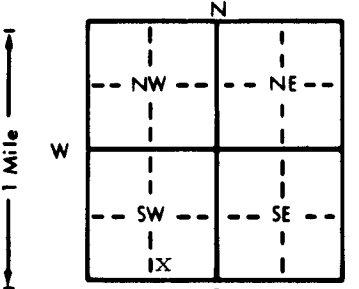


1 LOCATION OF WATER WELL: Fraction SW 1/4 SE 1/4 SW 1/4 Section Number 36 Township Number T 9 S Range Number R 39 W E/W
 County: Sherman Distance and direction from nearest town or city street address of well if located within city?
 N/A - LOCATION CONFIRMED BY GMD #4

2 WATER WELL OWNER: Dwight & Kay Briney Board of Agriculture, Division of Water Resources
 RR#, St. Address, Box #: Rt 1 Box 75 Application Number:
 City, State, ZIP Code: Edson, KS 67733

3 LOCATE WELL'S LOCATION WITH AN "X" IN SECTION BOX:

 4 DEPTH OF COMPLETED WELL: 132' ft. ELEVATION:
 Depth(s) Groundwater Encountered 1. 132' ft. 2. ft. 3. ft.
 WELL'S STATIC WATER LEVEL: 128' ft. below land surface measured on mo/day/yr 3-15-90
 Pump test data: Well water was ft. after hours pumping gpm
 Est. Yield gpm: Well water was ft. after hours pumping gpm
 Bore Hole Diameter in. to ft., and in. to ft.
 WELL WATER TO BE USED AS:
 X1 Domestic 3 Feedlot 5 Public water supply 8 Air conditioning 11 Injection well
 2 Irrigation 4 Industrial 6 Oil field water supply 9 Dewatering 12 Other (Specify below)
 7 Lawn and garden only 10 Monitoring well
 Was a chemical/bacteriological sample submitted to Department? Yes No; If yes, mo/day/yr sample was submitted Water Well Disinfected? Yes No

5 TYPE OF BLANK CASING USED:
 X1 Steel 3 RMP (SR) 5 Wrought iron 8 Concrete tile CASING JOINTS: Glued Clamped
 2 PVC 4 ABS 6 Asbestos-Cement 9 Other (specify below) Welded
 7 Fiberglass Threaded
 Blank casing diameter .5 in. to ft., Dia in. to ft., Dia in. to ft.
 Casing height above land surface 10 in., weight lbs./ft. Wall thickness or gauge No.
 TYPE OF SCREEN OR PERFORATION MATERIAL:
 1 Steel 3 Stainless steel 5 Fiberglass 7 PVC 10 Asbestos-cement
 2 Brass 4 Galvanized steel 6 Concrete tile 8 RMP (SR) 11 Other (specify)
 9 ABS 12 None used (open hole)
 SCREEN OR PERFORATION OPENINGS ARE:
 1 Continuous slot 3 Mill slot 5 Gauzed wrapped 8 Saw cut 11 None (open hole)
 2 Louvered shutter 4 Key punched 6 Wire wrapped 9 Drilled holes
 7 Torch cut 10 Other (specify)
 SCREEN-PERFORATED INTERVALS: From ft. to ft., From ft. to ft., From ft. to ft.
 GRAVEL PACK INTERVALS: From ft. to ft., From ft. to ft., From ft. to ft.

6 GROUT MATERIAL: 1 Neat cement 2 Cement grout 3 Bentonite 4 Other 1 gal. clay. cement
 Grout intervals: From 132' ft. to 9' ft., From 9' ft. to 3' ft., From 3' ft. to 0' ft.
 What is the nearest source of possible contamination:
 1 Septic tank 4 Lateral lines 7 Pit privy 10 Livestock pens 14 Abandoned water well
 2 Sewer lines 5 Cess pool 8 Sewage lagoon 11 Fuel storage 15 Oil well/Gas well
 3 Watertight sewer lines 6 Seepage pit 9 Feedyard 12 Fertilizer storage 16 Other (specify below)
 13 Insecticide storage
 Direction from well? How many feet?

FROM	TO	LITHOLOGIC LOG	FROM	TO	PLUGGING INTERVALS
			132	9'	fill sand
	ENTER		9'	3	Cement
			3	0	dirt
		PLUGGING			
		INFORMATION			
		AT			
		RIGHT			

RECEIVED

APR 02 1990

DIVISION OF ENVIRONMENT

7 CONTRACTOR'S OR LANDOWNER'S CERTIFICATION: This water well was (1) constructed, (2) reconstructed, or (3) plugged under my jurisdiction and was completed on (mo/day/year) 3-15-90 and this record is true to the best of my knowledge and belief. Kansas
 Water Well Contractor's License No. This Water Well Record was completed on (mo/day/yr) under the business name of Armstrong Pump & Well by (signature) Mark Armstrong

OFFICE USE ONLY
T
R
E/W
SEC.
1/4
1/4
1/4