


1 LOCATION OF WATER WELL: Fraction NE 1/4 SW 1/4 NE 1/4 Section Number 16 Township Number T 9 S Range Number R 4 E (N)  
 County: OTTAWA

Distance and direction from nearest town or city street address of well if located within city?  
3545 Feet NORTH, 1504 Feet WEST FROM SOUTHEAST CORNER OF SECTION 16.

2 WATER WELL OWNER: KLEIN OIL  
 RR#, St. Address, Box # : 103 W. 1ST  
 City, State, ZIP Code : DELPHOS, KS 67436  
 Board of Agriculture, Division of Water Resources  
 Application Number:

3 LOCATE WELL'S LOCATION WITH AN "X" IN SECTION BOX: 4 DEPTH OF COMPLETED WELL 25.0 ft. ELEVATION: 1307.6  
 AN "X" IN SECTION BOX:

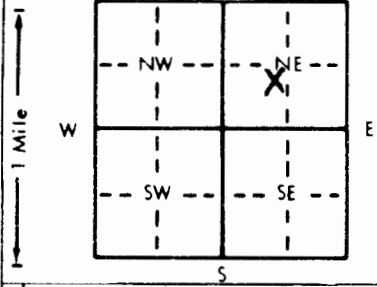

Depth(s) Groundwater Encountered 1. 19.0 ft. 2. ft. 3. ft.  
 WELL'S STATIC WATER LEVEL 18.29 ft. below land surface measured on mo/day/yr 11/17/93  
 Pump test data: Well water was ft. after hours pumping gpm  
 Est. Yield gpm: Well water was ft. after hours pumping gpm  
 Bore Hole Diameter 8 in. to 25.0 ft. and in. to ft.  
 WELL WATER TO BE USED AS: 5 Public water supply 8 Air conditioning 11 Injection well  
 1 Domestic 3 Feedlot 6 Oil field water supply 9 Dewatering 12 Other (Specify below)  
 2 Irrigation 4 Industrial 7 Lawn and garden only (10) Monitoring well  
 Was a chemical/bacteriological sample submitted to Department? Yes (No); If yes, mo/day/yr sample was submitted  
 Water Well Disinfected? Yes (No)

5 TYPE OF BLANK CASING USED: 5 Wrought iron 8 Concrete tile CASING JOINTS: Glued Clamped  
 1 Steel 3 RMP (SR) 6 Asbestos-Cement 9 Other (specify below) Welded  
(2) PVC 4 ABS 7 Fiberglass Threaded F.J.  
 Blank casing diameter 2 in. to 14 ft. Dia. in. to ft. Dia. in. to ft.  
 Casing height above land surface -0.37 in. weight lbs./ft. Wall thickness or gauge No. SCH 40

TYPE OF SCREEN OR PERFORATION MATERIAL: (7) PVC 10 Asbestos-cement  
 1 Steel 3 Stainless steel 5 Fiberglass 8 RMP (SR) 11 Other (specify)  
 2 Brass 4 Galvanized steel 6 Concrete tile 9 ABS 12 None used (open hole)

SCREEN OR PERFORATION OPENINGS ARE: 5 Gauzed wrapped 8 Saw cut 11 None (open hole)  
 1 Continuous slot (3) Mill slot 6 Wire wrapped 9 Drilled holes  
 2 Louvered shutter 4 Key punched 7 Torch cut 10 Other (specify)

SCREEN-PERFORATED INTERVALS: From 14.0 ft. to 24.0 ft. From ft. to ft.  
 From ft. to ft. From ft. to ft.  
 GRAVEL PACK INTERVALS: From 12.0 ft. to 25.0 ft. From ft. to ft.  
 From ft. to ft. From ft. to ft.

6 GROUT MATERIAL: 1 Neat cement (2) Cement grout (3) Bentonite 4 Other  
 Grout Intervals: From 0 ft. to 10 ft. From ft. to ft. From ft. to ft.

What is the nearest source of possible contamination:  
 1 Septic tank 4 Lateral lines 7 Pit privy (11) Fuel storage 14 Abandoned water well  
 2 Sewer lines 5 Cess pool 8 Sewage lagoon 12 Fertilizer storage 15 Oil well/Gas well  
 3 Watertight sewer lines 6 Seepage pit 9 Feedyard 13 Insecticide storage 16 Other (specify below)

Direction from well? How many feet?

FROM	TO	LITHOLOGIC LOG	FROM	TO	PLUGGING INTERVALS
0	1	CONCRETE			
1	3	FIRM DK. BROWN SILTY CLAY			
3	7.5	FIRM GRAY TO BROWN SILTY CLAY			
7.5	15	FIRM REDDISH BROWN SILTY CLAY W/ SAND			
15	18	BROWN, MED. GRAINED SAND			
18	19.5	REDDISH BROWN SILTY CLAY W/ SAND			
19.5	25.0	FIRM RED TO BROWN SILTY CLAY			

7 CONTRACTOR'S OR LANDOWNER'S CERTIFICATION: This water well was (1) constructed, (2) reconstructed, or (3) plugged under my jurisdiction and was completed on (mo/day/year) 11/12/93 and this record is true to the best of my knowledge and belief. Kansas Water Well Contractor's License No. 529 This Water Well Record was completed on (mo/day/yr) under the business name of GEOTECHNOLOGY, INC by (signature) HB Balaban