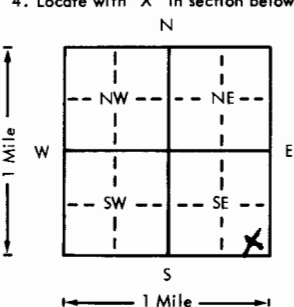


USE TYPEWRITER OR BALL POINT PEN-PRESS FIRMLY, PRINT CLEARLY.

WATER WELL RECORD  
KSA 82a-1201-1215

Kansas Department of Health and Environment-Division of Environment  
(Water well Contractors)  
Topeka, Kansas 66620

1. Location of well:	County <b>Ottawa</b>	Fraction <b>SE 1/4 SE 1/4 SE 1/4</b>	Section number <b>2074</b>	Township number <b>T 9 S R 4 E 10</b>	Range number	
2. Distance and direction from nearest town or city: <b>8 mi north of Minneapolis, Ks. west side of road</b>			3. Owner of well: <b>Martin Skirke</b> R.R. or street: <b>Rt. #1</b> City, state, zip code: <b>Delphos, Kansas 67436</b>	
4. Locate with "X" in section below: Sketch map: 			6. Bore hole dia. <b>29</b> in. Completion date _____ Well depth <b>243</b> ft. <b>6-30-77</b>	
5. Type and color of material			7. <input type="checkbox"/> Cable tool <input checked="" type="checkbox"/> Rotary <input type="checkbox"/> Driven <input type="checkbox"/> Dug <input type="checkbox"/> Hollow rod <input type="checkbox"/> Jetted <input type="checkbox"/> Bored <input type="checkbox"/> Reverse rotary	
<table border="1" style="width:100%; border-collapse: collapse;"> <thead> <tr> <th style="width:80%;">Type and color of material</th> <th style="width:10%;">From</th> <th style="width:10%;">To</th> </tr> </thead> <tbody> <tr><td>Top soil</td><td>0</td><td>3</td></tr> <tr><td>Yellow clay</td><td>3</td><td>8</td></tr> <tr><td>Red rock shale</td><td>8</td><td>9</td></tr> <tr><td>Good clean sand rock</td><td>9</td><td>28</td></tr> <tr><td>Fire clay</td><td>28</td><td>85</td></tr> <tr><td>Sand rock</td><td>85</td><td>108</td></tr> <tr><td>Shale pyrite</td><td>108</td><td>110</td></tr> <tr><td>Shale hard</td><td>110</td><td>116</td></tr> <tr><td>Pyrite</td><td>116</td><td>116</td></tr> <tr><td>Sand rock</td><td>116</td><td>181</td></tr> <tr><td>Shale &amp; sand rock streaks</td><td>181</td><td>190</td></tr> <tr><td>sand rock &amp; shale</td><td>190</td><td>200</td></tr> <tr><td>Sand rock</td><td>200</td><td>243</td></tr> <tr><td>Hard Pyrite</td><td>243</td><td></td></tr>Use: <input type="checkbox"/> Domestic <input type="checkbox"/> Public supply <input type="checkbox"/> Industry <input checked="" type="checkbox"/> Irrigation <input type="checkbox"/> Air conditioning <input type="checkbox"/> Stock <input type="checkbox"/> Lawn <input type="checkbox"/> Oil field water <input type="checkbox"/> Other		
9. Casing: Material <b>transite</b> Height: Above or below _____ Threaded <input type="checkbox"/> Welded <input checked="" type="checkbox"/> Surface <b>18</b> in. RMP _____ PVC _____ Weight _____ lbs./ft. Dia <b>16</b> in. to <b>243</b> ft. depth Wall thickness: inches or _____ Dia. _____ in. to _____ ft. depth gage No. <b>1 Transite</b>			10. Screen: Manufacturer's name <b>Johnson Transite</b> Type <b>slot transite</b> Slot/gauge <b>2 1/2</b> Length <b>78</b> Set between <b>165</b> ft. and <b>243</b> ft. _____ ft. and _____ ft. Gravel pack? <input checked="" type="checkbox"/> Size range of material <b>1/4 3/8</b>	
11. Static water level: _____ mo./day/yr. <b>75</b> ft. below land surface Date <b>4-8-77</b>			12. Pumping level below land surfaces: <b>138</b> ft. after <b>5</b> hrs. pumping <b>1000</b> g.p.m. _____ ft. after _____ hrs. pumping _____ g.p.m. Estimated maximum yield <b>1000</b> g.p.m.	
13. Water sample submitted: _____ mo./day/yr. <input checked="" type="checkbox"/> Yes <input type="checkbox"/> No Date <b>4-8-77</b>			14. Well head completion: <input type="checkbox"/> Pitless adapter _____ Inches above grade	
15. Well grouted? <input checked="" type="checkbox"/> With: <input checked="" type="checkbox"/> Neat cement <input type="checkbox"/> Bentonite <input type="checkbox"/> Concrete Depth: From <b>0</b> ft. to <b>10</b> ft.			16. Nearest source of possible contamination: ft. <b>74</b> Direction <b>west</b> Type <b>septic</b> Well disinfected upon completion? <b>HTH</b> Yes <input type="checkbox"/> No <input type="checkbox"/>	
17. Pump: _____ Not installed Manufacturer's name <b>W.F.R.</b> Model number <b>6-17CH</b> HP <b>80</b> Volts _____ Length of drop pipe <b>180</b> ft. capacity <b>20</b> g.p.m. Type: <input type="checkbox"/> Submersible <input checked="" type="checkbox"/> Turbine <input type="checkbox"/> Jet <input type="checkbox"/> Reciprocating <input type="checkbox"/> Centrifugal <input type="checkbox"/> Other			18. Elevation: Topography: <input type="checkbox"/> Hill <input type="checkbox"/> Slope <input checked="" type="checkbox"/> Upland <input type="checkbox"/> Valley	
19. Remarks: <b>gage no. is not available.</b>			20. Water well contractor's certification: This well was drilled under my jurisdiction and this report is true to the best of my knowledge and belief. <b>Rosencantz-Burns</b> License No. <b>134</b> Business name _____ Address <b>Shert Bend, Ks 67530</b> Signed <b>Sandy Kilgore</b> Date <b>7-22-77</b> Authorized representative	

Forward the white, blue and pink copies to the Department of Health and Environment

Form WWC-5

T 9 S R 4 E 10  
 Sec 2074  
 1/4 1/4 1/4 1/4  
 SE SE SE SE