

1	LOCATION OF WATER WELL:	Fraction	Section	Number	Township	Number	Range	Number
	County: SHERMAN	SW $\frac{1}{4}$ SE $\frac{1}{4}$ SE $\frac{1}{4}$	1		9 S		40W	E/W


Distance and direction from nearest town or city street address of well if located within city?

2 WATER WELL OWNER: Ginny A Linin Trust

RR #, St. Address, Box #: 1815 HWY 24
City, State, ZIP Code : Goodland KS 67735

Board of Agriculture, Division of Water Resources
Application Number: 5408

3 MARK WELL'S LOCATION WITH AN "X" IN SECTION BOX:

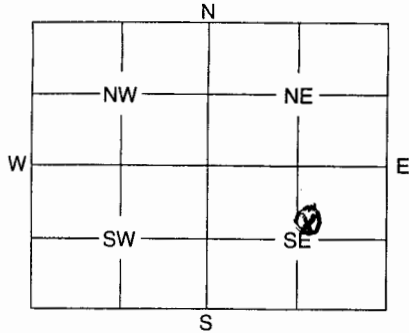

4 DEPTH OF WELL 191 ft.

WELL'S STATIC WATER LEVEL 164 ft.

WELL WAS USED AS:

- | | | |
|--------------|----------------------------|--------------------|
| 1 Domestic | 5 Public Water Supply | 9 Dewatering |
| 2 Irrigation | 6 Oil Field Water Supply | 10 Monitoring Well |
| 3 Feedlot | 7 Domestic (Lawn & Garden) | 11 Injection Well |
| 4 Industrial | 8 Air Conditioning | 12 Other |

Was a chemical / bacteriological sample submitted to Department? Yes No X

If yes, mo/day/yr sample was submitted

Water Well Disinfected: Yes ...XX... No 1 1/2# HTH

5 TYPE OF BLANK CASING USED:

- | | | | | |
|---------|------------|-------------------|-----------------|-------------------------|
| 1 Steel | 3 RMP (SR) | 5 Wrought | 7 Fiberglass | 9 Other (Specify below) |
| 2 PVC | 4 ABS | 6 Asbestos-Cement | 8 Concrete Tile | |

Blank casing diameter 103/4 in. Was casing pulled? Yes ...XX... No If yes, how much 7FT

Casing height above or below land surface 84 in.

6 GROUT PLUG MATERIAL: 1 Neat cement 2 Cement grout 3 Bentonite 4 Other

Grout Plug Intervals: From 130 ft. to 124.5 ft., From 9 ft. to 7 ft., From 7 to 5 ft.

What is the nearest source of possible contamination:

- | | | | |
|--------------------------|-------------------|-------------------------|--------------------------|
| 1 Septic tank | 6 Seepage pit | 11 Fuel storage | 16 Other (specify below) |
| 2 Sewer lines | 7 Pit privy | 12 Fertilizer storage | .. FARMSTEAD |
| 3 Watertight sewer lines | 8 Sewage lagoon | 13 Insecticide storage | |
| 4 Lateral lines | 9 Feedyard | 14 Abandoned water well | |
| 5 Cess pool | 10 Livestock pens | 15 Oil well/Gas well | |

Direction from well? ...Northeast..... How many feet? Approx 700'

FROM	TO	PLUGGING MATERIALS
191'	130'	Chlorinated gravel (38.4 CU FT)
130'	124.5'	Bentonite chips (5Bags)
124.5'	9'	Native Clays
9'	7'	Bentonite Chips (2 Bags)
7'	7'	1/4" Steel plate welded solid to casing
7'	5'	Bentonite Chips (10 Bags) Packed around bore hole
5'	0'	Native Clays backfilled to surface

7 CONTRACTOR'S OF LANDOWNER'S CERTIFICATION: This water well was plugged under my jurisdiction and was completed on (mo/day/year) 4-04-06 and this record is true to the best of my knowledge and belief. Kansas Water Well Contractor's License No. 633 This Water Well Record was completed on (mo/day/year) under the business name of DMW WELL & PUMP SERVICE

by (signature) ...*Gary T. Burnett*.....

INSTRUCTIONS: Use typewriter or ball point pen. Please press firmly and print clearly. Please fill in blanks, underline or circle the correct answers. Send top three copies to Kansas Department of Health and Environment, Bureau of Water, Geology Section, 1000 SW Jackson St., Ste. 420, Topeka, Kansas 66612-1367. Telephone: 785/296-5522. Send one to Water Well Owner and retain one for your records.