


1 LOCATION OF WATER WELL: County: <u>SHERMAN</u>	Fraction <u>SW 1/4 SE 1/4 SE 1/4</u>	Section Number <u>1</u>	Township Number <u>T 9 S</u>	Range Number <u>R 40W E/W</u>
---	---	----------------------------	---------------------------------	----------------------------------

Distance and direction from nearest town or city street address of well if located within city?

2 WATER WELL OWNER: Ginny A Linin Trust  
 RR#, St. Address, Box # : 1815 HWY 24 Board of Agriculture, Division of Water Resources  
 City, State, ZIP Code : Goodland KS 67735 Application Number: 5408

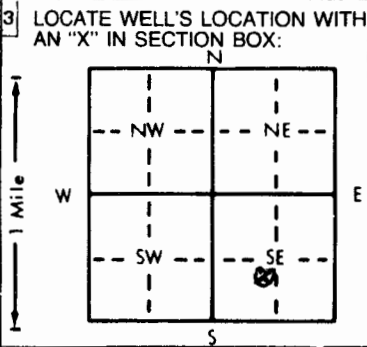

4 DEPTH OF COMPLETED WELL: 260 ft. ELEVATION: N/A  
 Depth(s) Groundwater Encountered 1. 167 ft. 2. \_\_\_\_\_ ft. 3. \_\_\_\_\_ ft.  
 WELL'S STATIC WATER LEVEL 167 ft. below land surface measured on mo/day/yr 4-03-06  
 Pump test data: Well water was 244 ft. after 18 hours pumping 220 gpm  
 Est. Yield 220 gpm: Well water was \_\_\_\_\_ ft. after \_\_\_\_\_ hours pumping \_\_\_\_\_ gpm  
 Bore Hole Diameter 30 in. to 258, 5 ft., and 17 in. to 260 ft.  
 WELL WATER TO BE USED AS:  
 1 Domestic  3 Feedlot  6 Oil field water supply  9 Dewatering  12 Other (Specify below) \_\_\_\_\_  
 2 Irrigation  4 Industrial  7 Lawn and garden only  10 Monitoring well   
 Was a chemical/bacteriological sample submitted to Department? Yes \_\_\_\_\_ No ; If yes, mo/day/yr sample was submitted \_\_\_\_\_  
 Water Well Disinfected?  Yes HTH No \_\_\_\_\_

5 TYPE OF BLANK CASING USED:  
 1 Steel  3 RMP (SR)  5 Wrought iron  8 Concrete tile CASING JOINTS: Glued \_\_\_\_\_ Clamped \_\_\_\_\_  
 2 PVC  4 ABS  6 Asbestos-Cement  9 Other (specify below) Welded \_\_\_\_\_  
 7 Fiberglass \_\_\_\_\_ Threaded \_\_\_\_\_  
 Blank casing diameter 16 in. to 190 ft., Dia 16" in. to 250' to 260' ft., Dia \_\_\_\_\_ in. to \_\_\_\_\_ ft.  
 Casing height above land surface 12 in., weight 42.05 lbs./ft. Wall thickness or gauge No. 250  
 TYPE OF SCREEN OR PERFORATION MATERIAL:  
 1 Steel  3 Stainless steel  5 Fiberglass  7 PVC  10 Asbestos-cement  
 2 Brass  4 Galvanized steel  6 Concrete tile  8 RMP (SR)  11 Other (specify) \_\_\_\_\_  
 9 ABS  12 None used (open hole)  
 SCREEN OR PERFORATION OPENINGS ARE:  
 1 Continuous slot  3 Mill slot  5 Gauzed wrapped  8 Saw cut  11 None (open hole)  
 2 Louvered shutter  4 Key punched  6 Wire wrapped  9 Drilled holes  
 7 Torch cut  10 Other (specify) \_\_\_\_\_  
 SCREEN-PERFORATED INTERVALS: From 190 ft. to 250 ft., From \_\_\_\_\_ ft. to \_\_\_\_\_ ft.  
 From \_\_\_\_\_ ft. to \_\_\_\_\_ ft., From \_\_\_\_\_ ft. to \_\_\_\_\_ ft.  
 GRAVEL PACK INTERVALS: From 260 ft. to 20 ft., From \_\_\_\_\_ ft. to \_\_\_\_\_ ft.  
 From \_\_\_\_\_ ft. to \_\_\_\_\_ ft., From \_\_\_\_\_ ft. to \_\_\_\_\_ ft.

6 GROUT MATERIAL:  1 Neat cement  2 Cement grout  3 Bentonite  4 Other \_\_\_\_\_  
 Grout Intervals: From 20 ft. to +1 ft., From \_\_\_\_\_ ft. to \_\_\_\_\_ ft., From \_\_\_\_\_ ft. to \_\_\_\_\_ ft.  
 What is the nearest source of possible contamination:  
 1 Septic tank  4 Lateral lines  7 Pit privy  10 Livestock pens  14 Abandoned water well  
 2 Sewer lines  5 Cess pool  8 Sewage lagoon  11 Fuel storage  15 Oil well/Gas well  
 3 Watertight sewer lines  6 Seepage pit  9 Feedyard  12 Fertilizer storage  16 Other (specify below) \_\_\_\_\_  
 \_\_\_\_\_  \_\_\_\_\_  \_\_\_\_\_  \_\_\_\_\_  \_\_\_\_\_  \_\_\_\_\_  \_\_\_\_\_  \_\_\_\_\_  
 Direction from well? Northeast How many feet? Approx 975'

FROM	TO	LITHOLOGIC LOG	FROM	TO	LOGGING INTERVALS
0	2	topsoil	233	237	Coarse sand, greensandy clay
2	42	clay, sandy clay	237	249	Coarse sand, gravel, green sandy clay
42	56	clay, sand, sandstone, big rock	249	251	Ochre, green shale
56	98	sand, gravel, clay, sandstone	251	260	Black shale
98	111	sand, small gravel, clay			
111	122	clay, sand, sandstone			
122	148	sand, sandy clay, gravel			
148	163	sand, gravel, sandstone, clay			
163	190	sand, sandstone, clay, rock			
190	196	fine to coarse sand			
196	203	sand, sandstone, rock			
203	216	sand, gravel, sandy clay			
216	219	fine to coarse sand, sandy clay			
219	231	sandy clay, clay			
231	233	coarse sand sandy clay			

7 CONTRACTOR'S OR LANDOWNER'S CERTIFICATION: This water well was  (1) constructed,  (2) reconstructed, or  (3) plugged under my jurisdiction and was completed on (mo/day/year) 4-4-06 and this record is true to the best of my knowledge and belief. Kansas Water Well Contractor's License No. 633 This Water Well Record was completed on (mo/day/yr) 5-15-06 under the business name of DMW WELL & PUMP SERVICE by (signature) Ginny T. Hudnell