

USE TYPEWRITER OR BALL POINT PEN-PRESS FIRMLY, PRINT CLEARLY.


WATER WELL RECORD
KSA 82a-1201-1215

Kansas Department of Health and Environment-Division of Environment (Water well Contractors) Topeka, Kansas 66620

DAA

1. Location of well: County SHERMAN Fraction NE 1/4 NE 1/4 SE 1/4 Section number 8 Township number T 9 S R 40 Range number EW

2. Distance and direction from nearest town or city: Goodland
Street address of well location if in city: 4 W 3 S
3. Owner of well: LeROY, EVERT
R.R. or street: RFD 1
City, state, zip code: Goodland Kansas 67235

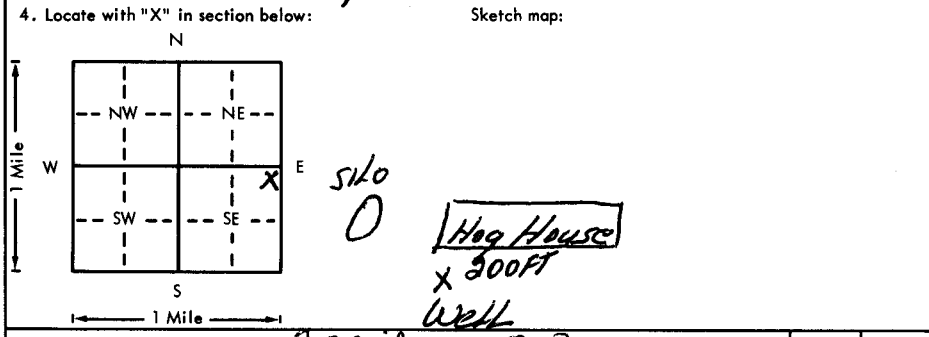

6. Bore hole dia. 8 in. Completion date 4-26-76
Well depth 248 ft.
7. Cable tool Rotary Driven Dug
 Hollow rod Jetted Bored Reverse rotary
8. Use: Domestic Public supply Industry
 Irrigation Air conditioning Stock
 Lawn Oil field water Other
9. Casing: Material Plastic Height: Above or below
Threaded Welded Surface 12 in.
RMP PVC Weight lbs./ft.
Dia. 4 in. to 232 ft. depth Wall Thickness: inches or
Dia. in. to ft. depth gage No. 200-237

5. Type and color of material	From	To
<u>M GRAVEL</u>	<u>128</u>	<u>136</u>
<u>M GRAVEL, SANDY CLAY</u>	<u>136</u>	<u>143</u>
<u>M GRAVEL, SANDSTONE</u>	<u>143</u>	<u>156</u>
<u>M GRAVEL, SANDY CLAY</u>	<u>156</u>	<u>191</u>
<u>FINE SAND, SANDY CLAY</u>	<u>191</u>	<u>218</u>
<u>CLAY, ROCK</u>	<u>218</u>	<u>222</u>
<u>M GRAVEL, SANDY CLAY</u>	<u>222</u>	<u>237</u>
<u>M GRAVEL, SANDSTONE</u>	<u>237</u>	<u>241</u>
<u>Ochre</u>	<u>241</u>	<u>248</u>
<u>ROCK 241'</u>		

10. Screen: Manufacturer's name Jessy Lowell
Type Louver Dia. 5"
Slot/gauze 18 Dia. 200 Length 16'
Set between 238 ft. and 248 ft.
ft. and ft.
Gravel pack? Size range of material 1/8
11. Static water level: 130 ft. below land surface Date 3-15-76 mo./day/yr.
12. Pumping level below land surfaces:
160 ft. after 3 hrs. pumping 20 g.p.m.
 ft. after hrs. pumping g.p.m.
Estimated maximum yield 50 g.p.m.
13. Water sample submitted: mo./day/yr.
 Yes No Date
14. Well head completion:
 Pitless adapter 12 Inches above grade
15. Well grouted? YES
With: Neat cement Bentonite Concrete
Depth: From 5 ft. to 15 ft.
16. Nearest source of possible contamination: 160
ft. 200 Direction South Type house
Well disinfected upon completion? Yes No
17. Pump: Not installed
Manufacturer's name Red Jacket
Model number 148C HP 1 Volts 220
Length of drop pipe 189 ft. capacity 10 g.p.m.
Type:
 Submersible Turbine
 Jet Reciprocating
 Centrifugal Other

18. Elevation: 3744
19. Remarks:
Topography:
 Hill
 Slope
 Upland
 Valley
20. Water well contractor's certification:
This well was drilled under my jurisdiction and this report is true to the best of my knowledge and belief.
St H Dullany Co Inc 166
Business name Goodland Kansas License No.
Address
Signed Bill Chaffin Date 4-26-76
Authorized representative

T 9 R 40 EW 200-237